


SECTION 7 TOWNSHIP 20 RANGE 19 W

WELL NO. #3 Schneider

COMPANY N C R A

NORTH

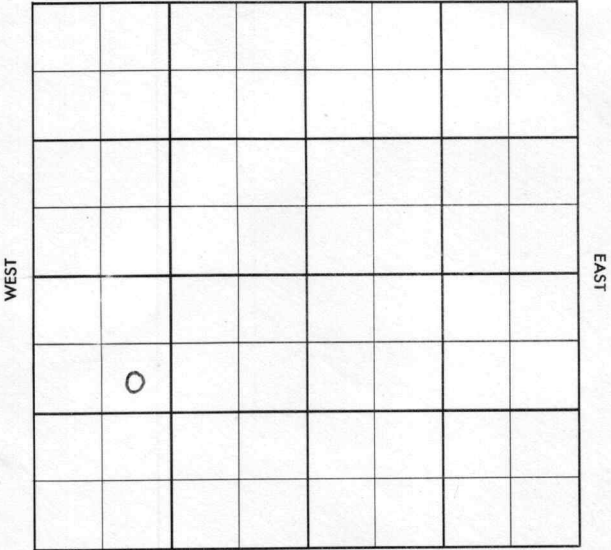

SOUTH

Pawnee

KANSAS

SEC. 7	TWP. 20	R. 19W
-----------	------------	-----------

WELL NO. #3 Schneider FARM

COMPANY N C R A

CONTRACTOR Armer


Shiley-East

_____ Ft. from N. Line

_____ Ft. from S. Line

_____ Ft. from E. Line

_____ Ft. from W. Line

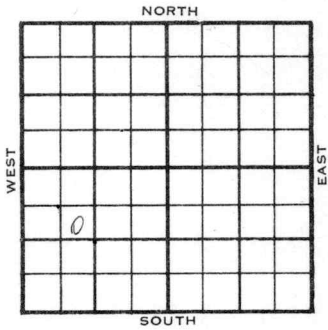

SE NW SW

1956	ELEVATION	REPORT
------	-----------	--------

1-25 MIR

County Pawnee Elev. _____
 Sec. 7 Twp. 20 Rge. 19W
 Company N C R A
 Farm Name Schneider No. 3

TOPS	DEPTH	LOG	DATUM
Anh.			
Tp.			
H.			
Tr.			
Dg.			
B.L.			
L.			
K.C.			
B.K.C.			
Ce.			
C.			
M.			
M.			
K.			
Mz.			
Mq.			
V.			
S.			
S.			
A.			
R.			
Pe.			
G.			
T.D.			

Loc. in Sec. SE NW SW
 Geol. _____
 Contr. Armer
 Pool Shiley East

FIRST REPORT
 JAN 25 1956

Date Comm. M I R

[Handwritten signature]

Co.
Lse.
No.
Sec.
T.
R.

County Parmer Elev. 2250
 Sec. 7 Twp. 20 Rgn. 19W
 Company N O R A
 Firm Name Schneider No. 3

	TOPS	DEPTH	LOG	DATUM	Loc. in Sec.																								
Arb.		1440			SE NW SW																								
Tp.																													
H.		2725																											
Tr.																													
Dp.																													
Bl.																													
L.		3772		1522	Geol.																								
K.C.																													
Dist.		4110		1860	Conts.																								
C.	sd	4264		2014	Armer																								
C.		4337		2087																									
M.					Pool																								
M.					Shiley East																								
K.																													
Me.					<table border="1"> <tr><td></td><td></td><td></td></tr> <tr><td></td><td></td><td></td></tr> <tr><td></td><td></td><td></td></tr> <tr><td></td><td></td><td></td></tr> <tr><td></td><td></td><td></td></tr> <tr><td></td><td></td><td></td></tr> <tr><td></td><td></td><td></td></tr> <tr><td></td><td></td><td></td></tr> </table>																								
V.																													
S.																													
S.																													
A.																													
R.																													
PE																													
R.																													
SO		4348																											

ABANDONED

Date Comm.

FEB 22 1956

MIR FEB 1 56 1-24-56 8578

505/275 2810 FEB 8 56 4444

FEB 15 56 4260-95 FEB 22 56

1hr 210' WM FP 80-160

314 860/20

W.O.A.