


Section 19 Township 19 Range 5W

Well No. #1 Myers


Company Trans-Era & S.J. Carter

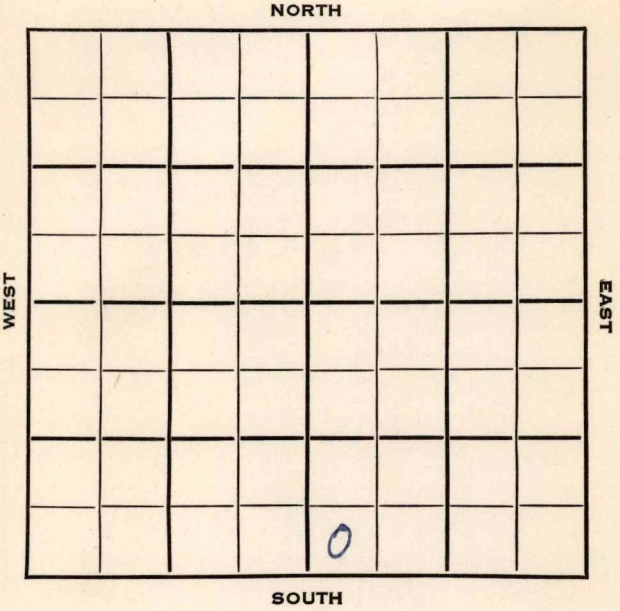

SEC.	TWP.	R.
19	19	5W ✓
WELL NO.		
1 Myers		
COMPANY		FARM
Trans-Era & S. J. Carter		
CONTRACTOR		

\_\_\_\_\_ Ft. from N. Line  
 330 \_\_\_\_\_ Ft. from S. Line  
 \_\_\_\_\_ Ft. from E. Line  
 330 \_\_\_\_\_ Ft. from W. Line

SW SW SE

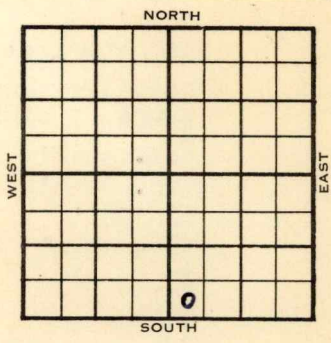

1953	ELEVATION 1641'	REPORT
------	--------------------	--------

12/16 Location

1954  
1/6 8" @ 186'  
 Lans 2801', Cong 3404', Miss Chat 3420'  
 DST 3420-35', 1/2 hrs., 2100' gas, 120' MCO, 360' free oil, 15' wtr, 1150#  
 Mq 3832', V 3841', Simp 3863'  
 Drlg.

1/13 Arb. 3944'  
 RTD 3982'  
 5" @ 3940'

1/20 CO 3840' 48/3420-30 S/1 BOPH 250 MA  
 S/35 BOPH 2 hrs.

1/27 NR

OVER

1954  
2/17

Spud 12-17-53

Oil Well

TD 3982'

8" @ 186'

Lans 2801', Cong 3404', Miss chat  
3420'

DST 3420-35', opn  $\frac{1}{2}$  hrs., rec. 2100'  
gas, 120' MCO, 360' free oil, 15' wtr  
1150#

Maq. 3832', Viola 3841', Simp 3863',  
Arb. 3944'

TD 3982'

5" @ 3940'

CO to 3840

48/3420-30

S/1 boph 250 ~~mud~~ mud-acid

S/35 boph

Comp. 400 bopd

COMPLETED



