


Section 18 Township 20 Range 19W
Well No. 1 Ekert
Company N C R A

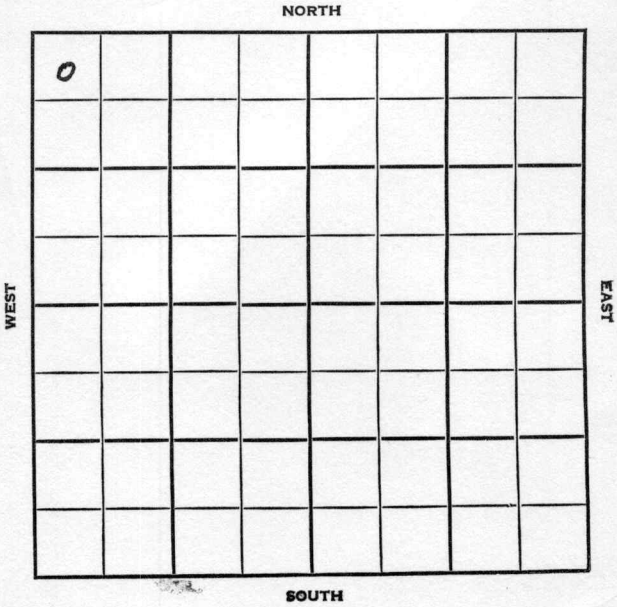

Pawnee KANSAS

SEC.	TWP.	R.
18	20	19W

WELL NO.

1 Ekert

FARM

COMPANY

N C R A

CONTRACTOR

Todd

Wildcat

330


Ft. from N. Line

Ft. from S. Line

Ft. from E. Line

330

Ft. from W. Line

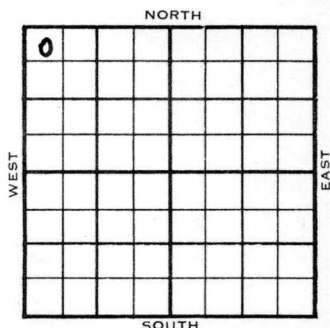

NW NW NW

CSD - DHM

1954	ELEVATION	REPORT
	2225'	

8/25
10/6

8" @ 243', WOC
Spud 8-23-54
Oil Well
TD 4300'
8" @ 243'
Anhy 1355', Heeb 3657', Tor. 3676'
Lans 3703', Cherokee 4161'
DST 4190'-97' opn 1 hr, rec 30' Mud
O#
DST 4211'-32' opn 2 hr, rec 2640'
free oil, 990#
DST 4232'-50' opn 2 hr, rec 560' s.w
610# Miss 4280'
TD 4300'
5" @ 4299'
CO to 4270'
12/ 4223-25 FU 150' oil 15 min
210' in 25 min. FU 880' oil 70 min
S/ 15.86 bo 1 hr. FU 2520' oil 14 hr.
Comp 91 bopd.

COMPLETED

County **Pawnee** State **Kansas**Sec. **18** (Blk.) **20** (Sur.) **19W** Map No.Operator **N C R A**Well No. **1** Farm **Ekert**Elev. Location **NW NW NW****330** Ft. From **N** Line **NW****330** Ft. From **W** Line Quarter1st. Report **AUG 25 1954**


Completion

Remarks **CSO - DHM****Todd - Contr.**

Spudding Date

Drlg. Data **Wildcat****8" @ 243 WOC**

FABEN GILSTRAP

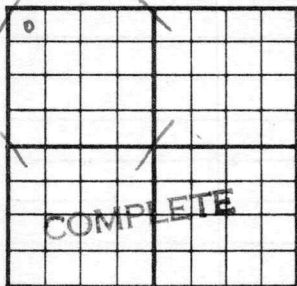County Pawnee State KansasSec. 18 (Blk.
Twp.) 20 (Sur.
Rge.) 19W Map No.Operator N C R AWell No. 1 Farm EkertElev. 2225 Location NW NW NW330 Ft. From N Line NW330 Ft. From W Line Quarter1st. ReportCompletion OCT 6 1954Remarks WildcatTodd - Contr.Spudding Date 8-23-54Drlg. Data Oil well TD 43008" @ 243 Anhy 1355 Heeb. 3657Tor. 3676 Lans. 3703 Cherokee 4161DST 4190-97 open 1 hr. Rec. 30' mud0# DST 4211-32 open 2 hr. Rec. 2640'free oil 990# DST 4232-50 open 2 hr.Rec. 560' sw 610# Miss. 4280TD 4300 5" @ 4299 CO to 427012/ 4223-25 FU 150' oil 15 min.210' in 25 min. FU 880' oil 70 min.S/ 15.86 bo 1 hr. FU 2520' oil 14 hr.Comp. 91 bopd

FABEN GILSTRAP