


Section 18 - Township 20 Range 19W

Well No. #2 Eckert

Company N C R A

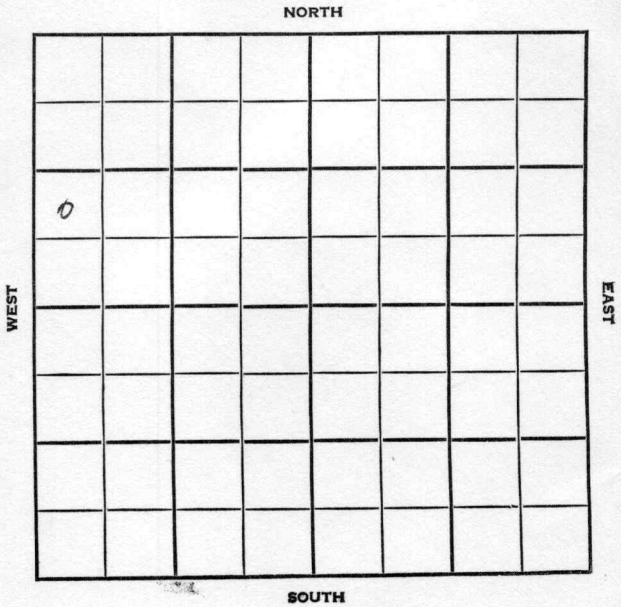

Pawnee KANSAS

SEC.	TWP.	R.
18	20	19W

WELL NO. 2 Eckert FARM

COMPANY N C R A

CONTRACTOR Sterling


E. Shiley Pool

_____ Ft. from N. Line

990 _____ Ft. from S. Line

_____ Ft. from E. Line

330 _____ Ft. from W. Line

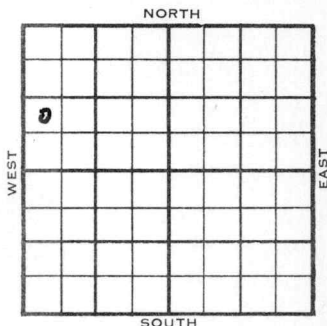

NW SW NW

1955	ELEVATION 2231'	REPORT
------	-----------------	--------

1/5 MIR

3/2 Spud 1-3-55 - Oil Well
 TD 4323'
 10" @ 457'
 Anhy 1350', Heeb. 3684', Mans 3731',
 sd 4201'
 DST 4194-4206', opn 1 hr., rec. 55'
 VSOCGM, 700#
 DST 4206-15', opn 1 hr., rec. 210'
 VSO & GCW, 0#
 DST 4221-32', opn 1 hr., rec. 1850'
 SMO, 980#
 Miss. 4313'
 TD 4323'
 7" @ 4323'
 16/4231-35, FU 1450' oil 1 hr.
 12/4235-38, FU 2035' oil 1 1/2 hrs.,
 S/45 bo S/155 bo 7 hrs.
 Comp. 120 bopd

COMPLETED

County Pawnee State Kansas

Sec. 18 (Blk.) 20 (Sur.) 19W Map No.

Operator N C R A

Well No. 2 Farm Eckert

Elev. _____ Location NW SW NW

0					
FIRST REPORT					

990 Ft. From S Line NW

330 Ft. From W Line Quarter

Ist. Report IAN 5 1955

Completion _____

Remarks _____

Sterling - Contr.

Spudding Date _____

Drlg. Data E. Shiley Pool

M I R

FABEN GILSTRAP

County Pawnee State Kansas

Sec. 18 (^{Blk.}_{Twps.}) 20 (^{Sur.}_{Rge.}) 19W Map No.

Operator N C R A

Well No. 2 Farm Eckert

Elev. 2231 Location NW SW NW

990 Ft. From S Line NW

330 Ft. From W Line Quarter

1st. Report

Completion MAR 2 1955

Remarks E. Shiley Pool

Sterling - Contr.

Spudding Date 1-3-55

Drlg. Data Oil well TD 4323

10" @ 457 Anhy 1350 Heeb. 3684

Lans. 3731 sd. 4201 DST 4194-4206

open 1 hr. Rec. 55' vsocgm 700#

DST 4206-15 open 1 hr. Rec. 210' vsc &

gcw 0# DST 4221-32 open 1 hr. Rec.

1850' smo 980# Miss. 4313 TD 4323

7" @ 4323 16/ 4231-35 FU 1450' oil

1 hr. 12/ 4235-38 FU 2035' oil 1 1/2 hr.

S/ 45 bo S/ 155 bo 7 hr.

Comp. 120 bopd

COMPLETE