


Section 18
~~8~~ Township 20 Range 19W

Well No. 3 Eckert

Company N C R A

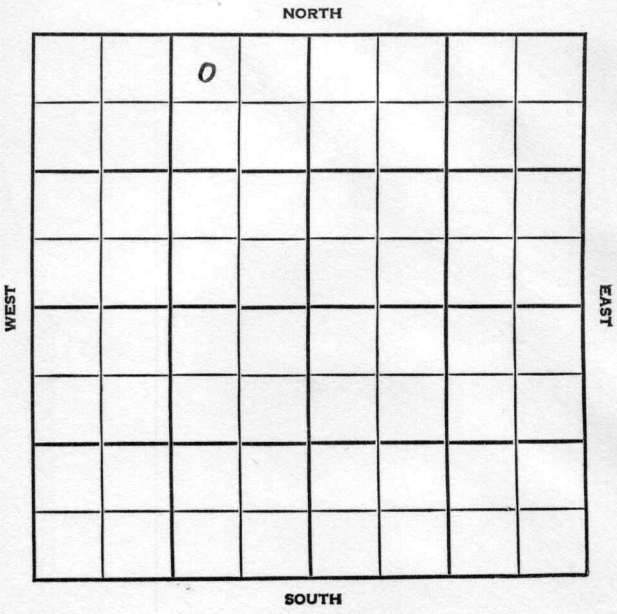

Pawnee KANSAS

SEC. 18A	TWP. 20	R. 19W
--------------------	-------------------	------------------

WELL NO. **3 Eckert** FARM

COMPANY **N C R A**

CONTRACTOR

E. Shiley Pool


330 Ft. from N. Line

Ft. from S. Line

990 Ft. from E. Line

Ft. from W. Line

NW NE NW

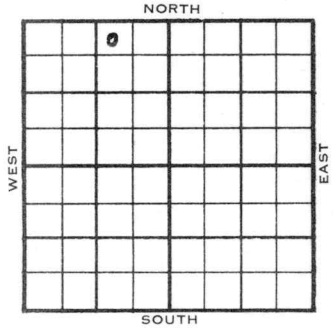

1955	ELEVATION	REPORT
------	-----------	--------

3/2 Location

County Pawnee State Kansas
 Sec. 8 (Blk.) 20 (Sur.) 19W Map No.
 Operator N C R A
 Well No. 3 Farm Eckert
 Elev. _____ Location NW NE NW

330 Ft. From N Line NW
990 Ft. From E Line Quarter
 1st. Report MAR 2 1955

Completion _____

Remarks _____

Spudding Date _____

Drlg. Data _____

E. Shiley Pool

Location

FABEN GILSTRAP

SCOUT TICKET

DX-201

Kansas

SEC.

18

TWP.

20

R.

19W

WELL NO.

3 Eckert

FARM

COMPANY

N C R A

CONTRACTOR

CORRECTION

NW NE NW

330

FT. FROM N. LINE


FT. FROM S. LINE

990

FT. FORM E. LINE

FT. FROM W. LINE

NORTH

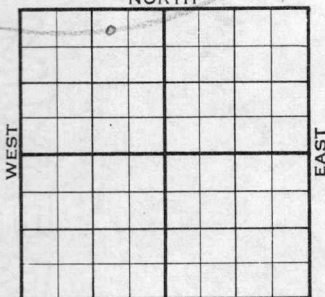

SOUTH

Pawnee County

☐

LOCATION

☐

RIG UP

DRILLING AND REMARKS:

Reported

8-20-19W

RECORD

CASED IN., FT.

SAND

GAS

OIL

TOTAL DEPTH

PRODUCTION

1ST 24 HRS. NAT.

1ST 24 HRS. AFTER SHOT

GAS CU. FT.

DRY HOLE

ABANDONED

DATE

MAR

2 1955

SCOUT

FABEN GILSTRAP