

Pawnee

KANSAS


SEC.	18	TWP.	20	R.	19W
------	----	------	----	----	-----

WELL NO. #1 Springer FARM

COMPANY N C R A

CONTRACTOR #1 Springer
E. Shiley

_____ Ft. from N. Line
 _____ Ft. from S. Line
 _____ Ft. from E. Line
 _____ Ft. from W. Line

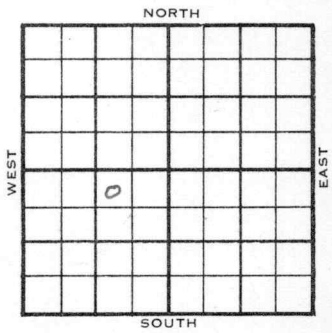

NW NE SW

1955	ELEVATION 2249'	REPORT
------	-----------------	--------

10/5 MIR
 10/26 Comp 10-5-55
 8 5/8" @ 480/400
 Anh 11405
 H 3733
 L 3781
 BKC 4119
 sd 4253
 M 4368
 TD 4372
 DST 4241-90 open 1 hr rec 345' gow
 825/20"
 D & A ABANDONED

County Patnee Elev. _____
 Sec. 18 Twp. 20 Rge. 19W
 Company N C R A
 Farm Name Springer No. 1

TOPS	DEPTH	LOG	DATUM	Loc. in Sec. _____
Anh.				NW NE SW
TP.				
H.				
Tr.				
Dg.				
Bl.				
L.				Geol. _____
K.C.				Contr. _____
B.K.C.				Strata
Ce.				
C.				Pool _____
M.				E. Shiley
M.				
K.				
Mz.				
Ma.				
V.				
S.				
S.				
A.				
R.				
PE.				
G.				
T.D.				

FIRST REPORT
 OCT 5 '55

Date Comm. M I R

Co.
Lse.
No.
Sec.
T.
R.

