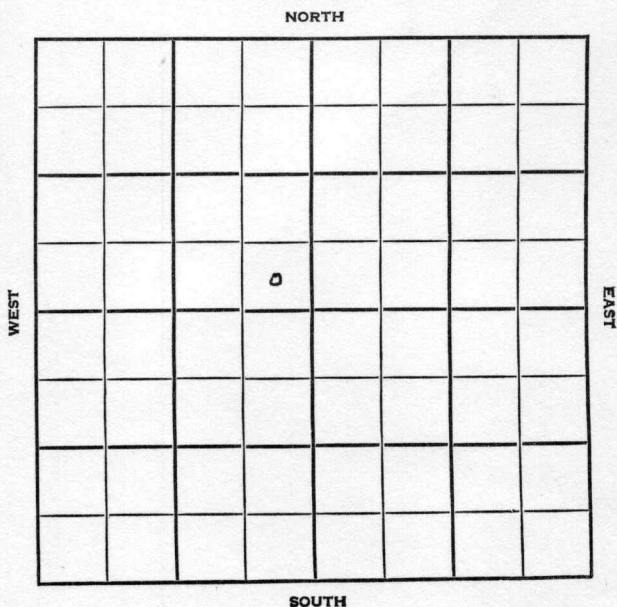


Section 34 Township 20 Range 19WWell No. #1-A JohnsonCompany Musgrove Pet.

Pawnee

KANSAS

SEC.	TWP.	R.
34	20	19W

WELL NO.

#1-A Johnson

FARM

COMPANY

Musgrove Pet.

CONTRACTOR

Wildcat.


_____ Ft. from N. Line

150 _____ Ft. from S. Line

330 _____ Ft. from E. Line

_____ Ft. from W. Line

SE SE NW

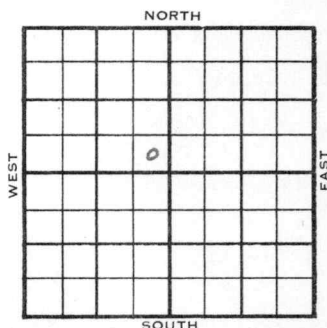

	ELEVATION	REPORT
1954	2232'	

10/13 8-5/8" @ 338'

Drlg. 1775'

10/27 Spud 9-30-54

D & A

TD 4530'

8-5/8" @ 338'

TD 3296'

Skid 50' North

8" @ 338'

Anhy 1380', Heeb 3756', Lans 3807'

Kh. 4458', Viola 4499' Cong 4274' Miss

Ch 4368', Miss Lm 4430' B KC 4105'

TD 4530'

D & A

ABANDONED

FABEN GILSTRAP

FABEN GILSTRAP