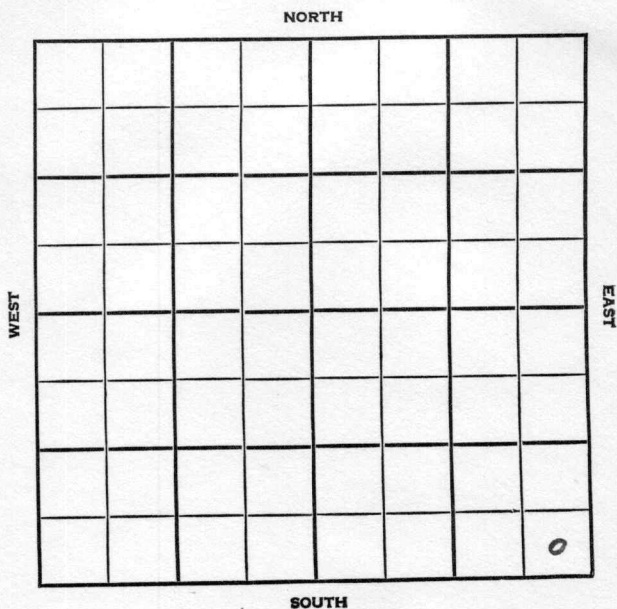


Section 12 Township 20 Range 20W
Well No. 1 Jennings "B"
Company Cities Service



Pawnee

KANSAS

SEC.	12	TWP.	20	R.	20W
------	----	------	----	----	-----

WELL NO.

#1 Jennings "B"

FARM

COMPANY

Cities Service

CONTRACTOR

Brack Drlg.

Shiley Pool

NORTH

Ft. from N. Line

330

Ft. from S. Line

330

Ft. from E. Line

Ft. from W. Line

							0

WEST

EAST

SOUTH

SE SE SE

	ELEVATION	REPORT
1954	2215'	

12/15 Gellar & Pits.

1955

1/26

Spud 12-15-54

Oil Well

TD 4305'

8" @ 503'

Heeb 3661', Dodge 3681' Lans 3708'

B KC 4019', Cherokee 4141', B. Penn Sd 4200'

DST 4198'-4208' opn 1 hr, rec 1720' smw 975#

DST 4217'-32' opn 1 hr, rec 140' smco 240' ocm, 960#

DST 4236'-41' opn 1/2 hr, rec 15' Mud, 1332# Miss 4287'

TD 4305'

5" @ 4305'

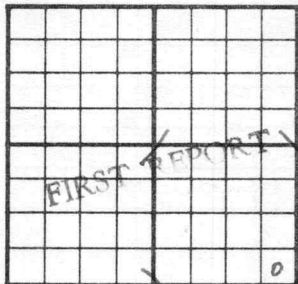
CO to 4285'

21/ 4217-23 26/ 4225-30 FU 505' oil

4 hr. S/ 1.67 boph 8 hr.

Comp 18 bopd. 1% Wtr.

COMPLETED

County Pawnee State KansasSec. 12 (Blk.
Twp.) 20 (Sur.
Rge.) 20W Map No.Operator Cities ServiceWell No. 1 Farm Jennings "B"Elev. Location SE SE SE330 Ft. From S Line SE330 Ft. From E Line Quarter1st. Report DEC 15 1954

Completion

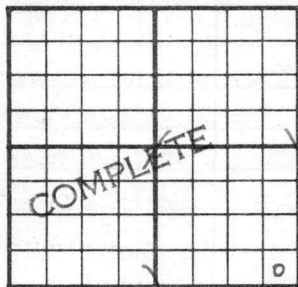
Remarks

Brack Drlg. - Contr.

Spudding Date

Drlg. Data Shiley PoolCellar & pits

FABEN GILSTRAP

County Pawnee State KansasSec. 12 (^{Blk.}Twp.) 20 (^{Sur.}Rge.) 20W Map No. _____Operator Cities ServiceWell No. 1 Farm Jennings "B"Elev. 2215 Location SE SE SE330 Ft. From S Line SE330 Ft. From E Line Quarter1st. ReportCompletion JAN 26 1955Remarks Shiley PoolBrack Drlg. - Contr.Spudding Date 12-15-54Drlg. Data Oil well TD 43058" @ 503 Heeb. 3661 Dodge 3681Ians. 3708 B KC 4019 Cherokee 4141B. Penn sd. 4200 DST 4198-4208open 1 hr. Rec. 1720' smw 975#DST 4217-32 open 1 hr. Rec. 140' smco240' ocm 960# DST 4236-41 open $\frac{1}{2}$ hr.Rec. 15# mud 1332# Miss. 4287TD 4305 5" @ 4305 CO to 428521/ 4217-23 26/ 4225-30 FU 505' oil4 hr. S/1.67 boph 8 hr.Comp. 18 bopd 1% wtr.

FABEN GILSTRAP