

Section 36 Township 20 Range 19 WWell No. # 1 FoxCompany A. F. Brann

NORTH

							0

SOUTH

WEST

EAST

Pawnee

KANSAS


Sec. 36 Twp. 20 R. 19WWell No. #1 Fox FarmA.F. Brann CompanyMusgrove Pet. ContractorWildcat.330 Ft. from N. Line

Ft. from S. Line

330 Ft. from E. Line

Ft. from W. Line

NE NE NE

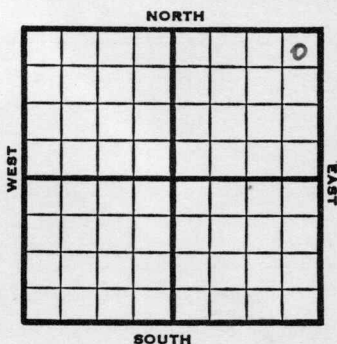

1953

Elev. 2122' REPORT

5/27

Location

6/3

8" @ 158

Anhy 1223

Drlg. 2610'

6/10

Heeb 3539 Br li 3591 Lans 3600

Drlg. 3850'

6/17

Spud 5-25-53 D & A TD 4158

8" @ 158 Anhy 1223 Heeb 3539

Br li 3591 Lans 3600

DST 4016-42 open $\frac{1}{2}$ hr rec 2' mud 0#

Cong 4035'

DST 4014-57 open 1 hr rec 60' mud

290# Arb 4123'

DST 4128-58 open $\frac{1}{2}$ hr rec 1750' SW

1270#

D & A

ABANDONED

County Pawnee State Kansas
 Sec. 36 (Blk.) 20 (Sur.) 19W Map No.
 Operator A. F. Brann
 Well No. 1 Farm Fox
 Elev. _____ Location NE NE NE

FIRST REPORT

330 Ft. From N Line NE
330 Ft. From E Line Quarter
 1st. Report MAY 27 1953
 Completion _____
 Remarks _____
Musgrove - Contr.
 Spudding Date _____

Drlg. Data Wildcat
Location

County Pawnee State KansasSec. 36 (Blk.
Twp.) 20 (Sur.
Rge.) 19W Map No.Operator A. F. BrannWell No. 1 Farm FoxElev. 2122 Location NE NE NE330 Ft. From N Line NE330 Ft. From E Line Quarter

1st. Report

Completion JUN 17 1953Remarks WildcatMusgrove - Contr.Spudding Date 5-25-53Drilg. Data D & A TD 41588" @ 158 Anhy 1223 Heeb. 3539Br. lime 3591 Lans. 3600 DST 4016-42open $\frac{1}{2}$ hr. Rec. 2' mud 0#Cong. 4035 DST 4014-57 open 1 hr.Rec. 60' mud 290# Arb. 4123 DST 4128-58 open $\frac{1}{2}$ hr. Rec. 1750' sw 1270#D & A

J. G. McGEHEE