


Section 20 Township 19S Range 5W

Well No. #1 Neel

Company Osage Oil Co

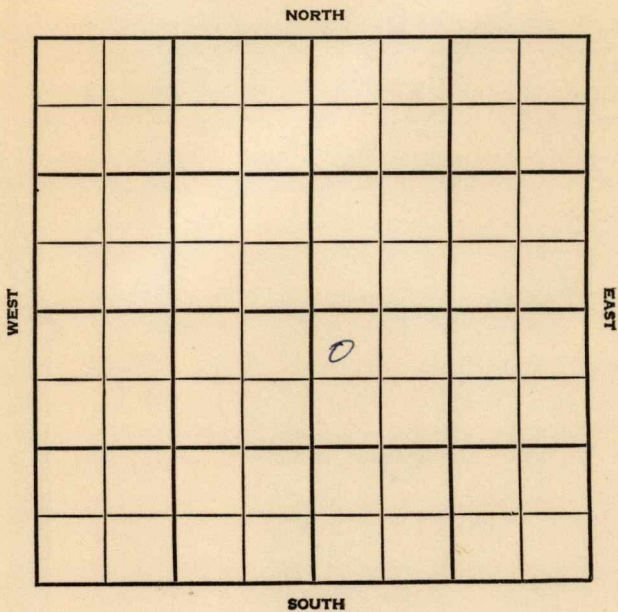

| | | |
|------------|------------|----------|
| SEC. 20 | TWP. 19 | R. 5W |
|------------|------------|----------|

WELL NO.

#1 Neel

FARM

COMPANY

Osage Oil Co.

CONTRACTOR

Ext to Windom


_____ FT. FROM N. LINE

_____ FT. FROM S. LINE

_____ FT. FROM E. LINE

_____ FT. FROM W. LINE

NW NW SE

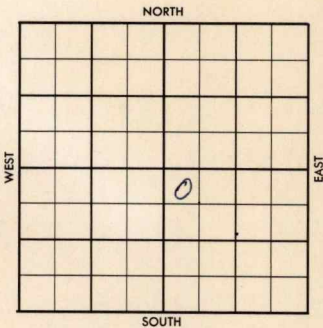

ELEVATION

REPORT

1956

8-29

Loc.

County McPherson Elev. _____
 Sec. 20 Twp. 19S Rge. 5W
 Company Osage Oil Co.
 Farm Name Neel No. 1

| TOPS | DEPTH | LOG | DATUM |
|--------|-------|-----|-------|
| Anh. | | | |
| Tp. | | | |
| H. | | | |
| Tr. | | | |
| Dg. | | | |
| Bl. | | | |
| L. | | | |
| K.C. | | | |
| B.K.C. | | | |
| Ce. | | | |
| C. | | | |
| M. | | | |
| M. | | | |
| K. | | | |
| Mz. | | | |
| Me. | | | |
| V. | | | |
| S. | | | |
| S. | | | |
| A. | | | |
| R. | | | |
| PE. | | | |
| G. | | | |
| T.D. | | | |

Loc. in Sec. _____
NW NW SE
DS - SE/4

Geol. _____
 Contr. _____


Pool Ext to
Windom

| | | |
|--------------|---|--|
| | | |
| FIRST REPORT | | |
| | o | |
| AUG 29 '56 | | |

Date Comm. _____
 Loc. _____

SEP 2 1956

R.G.

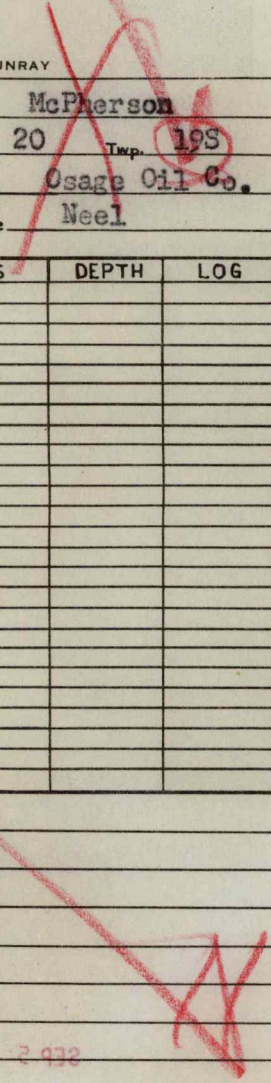

County McPherson Elev. 1622
 Sec. 20 Twp. 19S Rge. 5W
 Company Osage Oil Co.
 Farm Name Neel No. 1

| TOPS | DEPTH | LOG | DATUM | Loc. in Sec. |
|--------|-------|-----|-------|---------------------|
| Anh. | | | | NW NW SE |
| Ip. | | | | DS - SE/4 |
| H. | 2601 | | | |
| Tr. | | | | |
| Dg. | | | | |
| Bl. | 2788 | | | |
| L. | 2808 | | | |
| K.C. | | | | Geol. |
| B.K.C. | 3195 | | | Contr. <u>SERRA</u> |
| Ce. | | | | |
| C. | | | | |
| M. | 3451 | | | Pool Ext to Window |
| M. | | | | |
| K. | | | | |
| Mz. | | | | |
| Mo. | | | | |
| V. | | | | |
| S. | | | | |
| S. | | | | |
| A. | | | | |
| R. | | | | |
| PE. | | | | |
| G. | | | | |
| TD. | 3476 | | | |



Date Comm. LOC. SEP 5 '56 8-31-56 F5/8
188/100 # SEP 12 '56 WAR SEP 19 '56
ROR # 1010 SEP 26 '56 DST 3126
-50 or 45" net 30' Md
FP 30-30 BHP 40 # 3175
OCT 3 '56
DEA

Co.
No.
Sec.
T.
R.