


Section 11 Township 20 Range 20W

Well No. 2 Hazlett "B"

Company C. S. O.

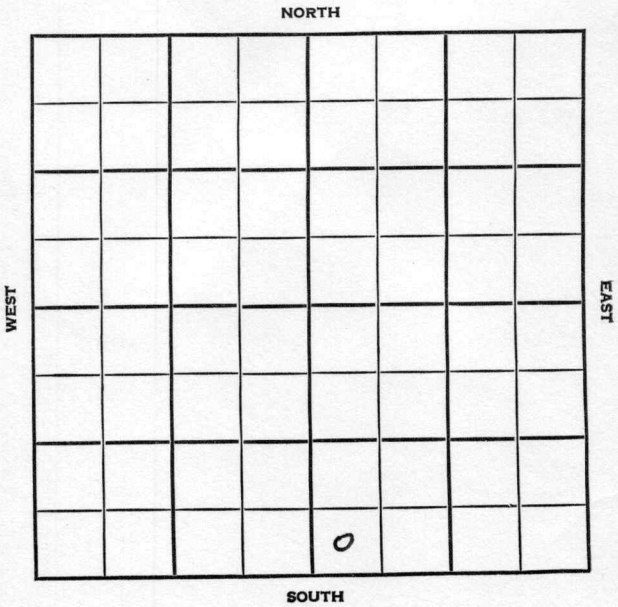


SEC. 11 TWP. 20 R. 20W ✓

WELL NO. 2 Hazlett "B" FARM

COMPANY C. S. O. CONTRACTOR

Shiley Pool

Ft. from N. Line
330 Ft. from S. Line
Ft. from E. Line
330 Ft. from W. Line

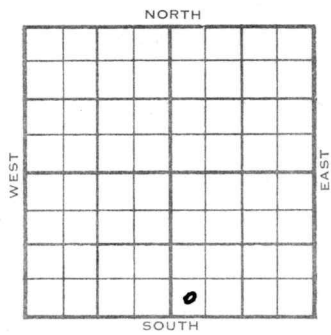

SW SW SE

Table with columns: DATE, ELEVATION, REPORT. Contains well log data for 1954, 6/9, and 6/23, including details like '8" @ 464', 'Drlg. 1425', 'Spudding 6-5-54', and 'ABANDONED'.



