

Section 14 Township 20 Range 20 W

Well No. # 2 Risse

Company Cities Service

NORTH

| | | | | | | | |
|--|--|--|--|--|--|---|--|
| | | | | | | | |
| | | | | | | 0 | |
| | | | | | | | |
| | | | | | | | |
| | | | | | | | |
| | | | | | | | |
| | | | | | | | |
| | | | | | | | |

WEST

EAST

SOUTH

Pawnee KANSAS

SEC. 14 TWP. 20 R. 20W ✓

WELL NO. 2 Risse FARM

COMPANY Cities Service


CONTRACTOR Brack

975 Shiley Pool Ft. from N. Line

Ft. from S. Line

982 Ft. from E. Line

Ft. from W. Line

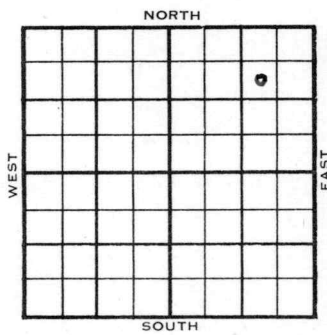

SW NE NE

1954 ELEVATION 2182' REPORT

3/31 Spud 3-27-54
8" @ 506'
Drlg. 550'

4/7 Anhy 1330', Heeb 3632', Dodge 3652',
Lans 3683'
Drlg. 3695'

5/5 Spud 3-27-54
OilWell
TD 4285'
8" @ 506'
Anhy 1330', Heeb 3632', Dodge 3652',
Lans 3683', Penn. sd 4160'
DST 4152-67', opn 1 hr., rec. 1107'
mud & sw, VSSG, 1060#
DST 4178-93', opn 1 hr., rec. 2900'
oil, 1140#
DST 4215-29', opnlhr., rec. 243'
mud & sw,
Miss 4271'
TD 4285'
5" @ 4285'
CO to 4264
41/4180-92,
FU 2652' oil 2 hr. 10", S/329 bo 9 hrs.
Comp. 488 bopd

COMPLETED

