


Section 14 Township 20 Range 20 W

Well No. # 3 Risse

Company Cities Service

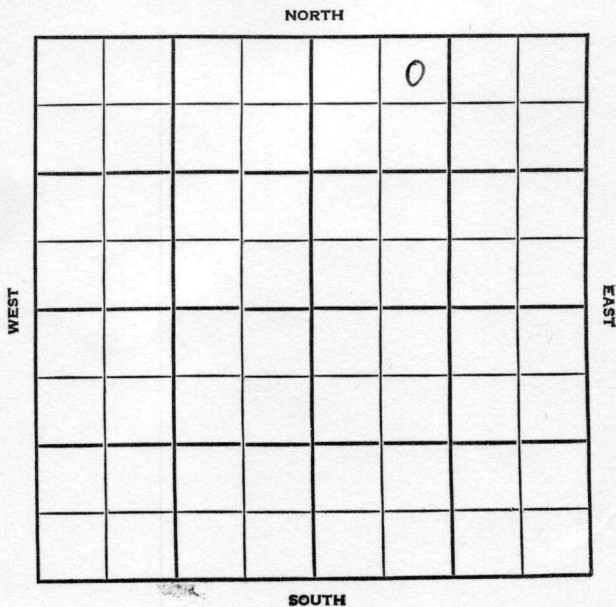

Pawnee KANSAS

SEC. 14 TWP. 20 R. 20W

WELL NO. 3 Risse FARM

COMPANY Cities Service


CONTRACTOR Brack Shiley Pool

330 Ft. from N. Line

Ft. from S. Line

Ft. from E. Line

990 Ft. from W. Line

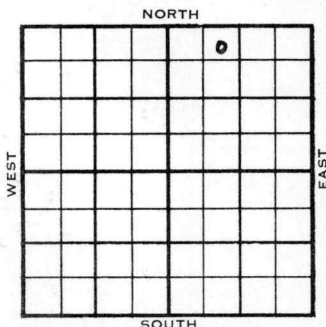

NE NW NE

1954 ELEVATION 2212' REPORT

5/19 Spud 5-16-54  
8" @ 501', WOC

5/26 Drlg. 3595'  
6/2 Heeb 3663', Dodge 3685', Lans 3713'  
DST 3819-26', 1 hr., 1680' SW, 1220#  
Chert. 4146'  
DST 4183-95', 1/2 hrs., 25' M  
Cong 4203'  
DST 4201-14, 1 hr., 1520' Oil, 120'  
mco, 980#  
DST 4222-43, 1/2 hrs., 22' M  
Drlg. 4272'

6/9 Miss 4285'  
RTD 4300'  
5" @ 4300'  
CO 4281'  
42/4202-14, 285' oil, 1/4 hrs., 1200'  
oil, 70",  
S/93 BO 9 hrs.

OVER

1954  
7/14

Spud 5-16-54 - Oil Well

TD 4300'

8" @ 501'

Heeb 3663', Dodge 3685', Lans 3713'

DST 3819-26', opn 1 hr., rec. 1680' sw  
1220#

Cherokee 4146'

DST 4183-95', opn 1/2 hrs., rec. 25'  
mud,

Cong ~~41~~ 4203'

DST 4201-14, opn 1 hr., rec. 1520'

oil, 120' mco, 980#

DST 4222-43', opn 1/2 hr., rec. 22'  
mud,

Miss 4285'

TD 4300'

5" @ 4300'

CO to 4281'

42/4202-14

FU 285' oil 1/4 hr., 1200' oil 70"

S/93 BP 9 hr.

Comp. 417 bopd

COMPLETED



