


Section 14 Township 20 Range 20W

Well No. 4 Risse "A"

Company Cities Service

NORTH

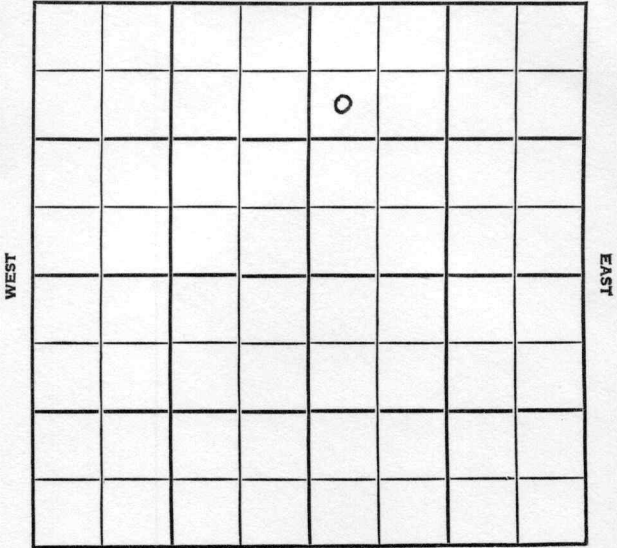

SOUTH

WEST

EAST

Pawnee KANSAS

| | | |
|------|------|-------|
| SEC. | TWP. | R. |
| 14 | 20 | 20W ✓ |

WELL NO. 4 Risse "A" FARM

COMPANY Cities Service

CONTRACTOR Brack Drlg.


Shiley Pool

990 Ft. from N. Line

_____ Ft. from S. Line

_____ Ft. from E. Line

330 Ft. from W. Line

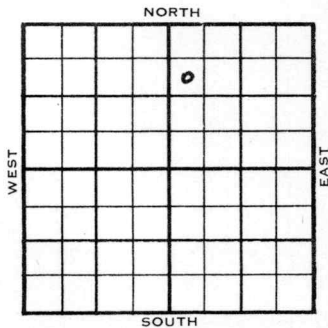

SW NW NE

| | ELEVATION | REPORT |
|------|-----------|--------|
| 1954 | 2209' | |

6/30 8" @ 450
Drlg. 2218

7/7 Heeb 3685 Dodge 3704 Lans 3737
Drlg. 4010'

7/14 Spud 6-24-54
D&A
TD 4330'
8" @ 450'
Heeb 3685'; Dodge 3704', Lans 3737',
B KC 4065', Cherokee 4173'
DST 4206-19', opn 1/2 hrs., rec. 15' mud,
O#
DST 4225-35', opn 1/2 hrs., rec. 5' mud,
O#
Cong 4237'
DST 4236-48', opn 1 hr., rec. 990' SW,
790#
Miss 4325'
TD 4330'
D&A

ABANDONED

County Pawnee State Kansas

Sec. 14 (Blk. Twp.) 20 (Sur. Rge.) 20W Map No.

Operator Cities Service

Well No. 4 Farm Risse "A"

Elev. 2209 Location SW NW NE

| | | | | | |
|--|--|--|--|--|--|
| | | | | | |
| | | | | | |
990 Ft. From N Line NE

330 Ft. From W Line Quarter

1st. Report

JUL 14 1954

Completion

Remarks Shiley Pool

Brack Drlg. - Contr.

Spudding Date 6-24-54

Drlg. Data D & A TD 4330

8" @ 450 Heeb. 3685 Dodge 3704

Lans. 3737 B KC 4065 Cherokee 4173

DST 4206-19 open 1/2 hr. Rec. 15' mud

0# DST 4225-35 open 1/2 hr. Rec. 5' mud

0# Cong. 4237 DST 4236-48 open 1 hr.

Rec. 990' sw 790# Miss. 4325 TD 4330

D & A

J. G. McGEHEE