


Section 14 Township 20S Range 20W
Well No. #1 Risse
Company Parker Pet. Co.

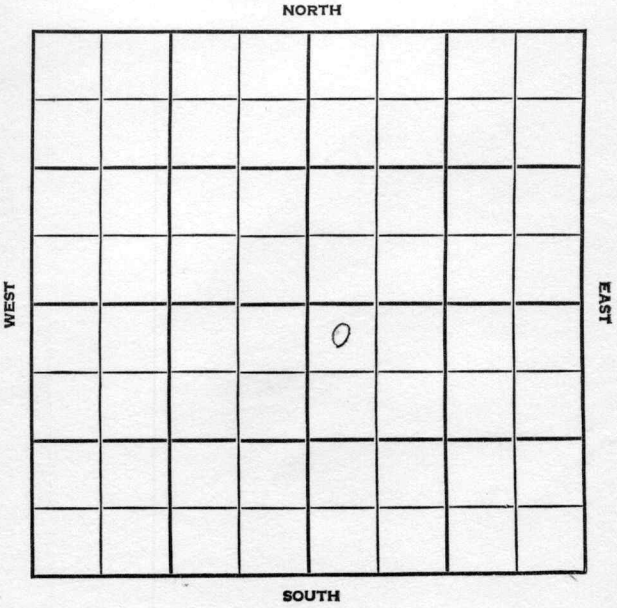

Pawnee

KANSAS

SEC.

14

TWP.

20

R.

20W

WELL NO.

#1 Risse

FARM

COMPANY

Parker Petr. Co.

CONTRACTOR

Smitherman


_____ FT. FROM N. LINE

_____ FT. FROM S. LINE

_____ FT. FROM E. LINE

_____ FT. FROM W. LINE

NW NW SE

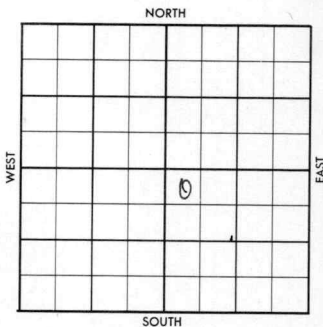

ELEVATION

REPORT

1956

6-13

To go 6-30-56

ABANDONED

County Pawnee Elev. 2217
 Sec. 14 Twp. 20S Rge. 20W
 Company Parker Pet. Co.
 Farm Name Risse No. 1


TOPS	DEPTH	LOG	DATUM
Anh.	1360		
TP.			
H.	3706	3684	
Tr. <u>Dodge</u>	3728		
Dg.			
Bl.			
L.	3763	3732	
K.C.			
B.K.C.			
Ce. <u>SA</u>	4169	4173	
Ce <u>sd</u>	4235-43		
M.	4326	4329	
M.			
K.			
Mz.			
Mq.			
V.			
S.			
A.			
R.			
PE.			
G.			
TD.	4366		

Loc. in Sec. NW NW SE

Geol. _____

Contr. Smitherman

Pool _____

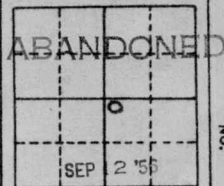

Date Comm. to go 6/30/56 JUN 20 '56 JUN 27 '56 JUL 3 '56

JUL 11 '56 ✓ JUL 18 '56 JUL 25 '56 AUG 1 '56 CSO F.O.

AUG 8 '56 AUG 15 '56 RUP 8-11-56

10" 526/325 AUG 22 '56 17 2960

AUG 29 '56 17 4040 SEP 5 '56 PST

4331-66 SEP 12 '56 OR 35" rec

2640' SW FP 150-1300 BIT

1350/20"

DBA