


McPherson

KANSAS

SECTION 28 30 TOWNSHIP 19 RANGE 5 W

WELL NO. # 3 Geiman

COMPANY Oil Trading

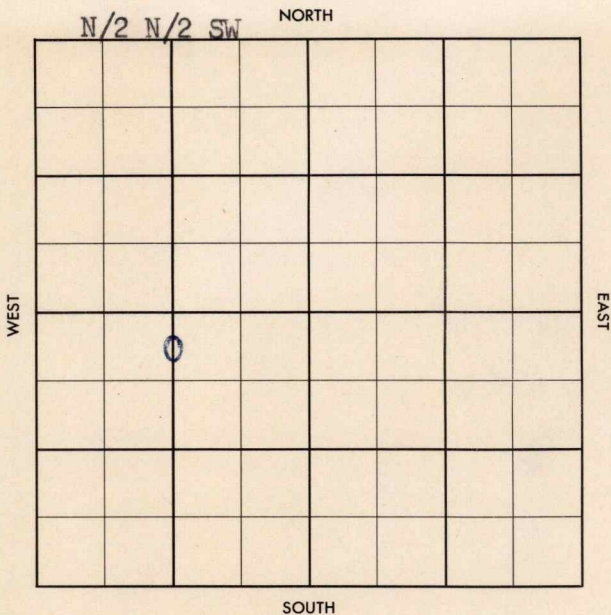

CORRECTION

FORM 513 SUNRAY

County McPherson Elev. 1610 DF
 Sec. 28 30 Twp. 19 Rge. 5W
 Company Oil Trading
 Farm Name Geiman No. 3

TOPS	DEPTH	LOG	DATUM	Loc. in Sec.
Anh.				N/2 N/2 SW
TP.				
H.	3581			
Tr.				
Dg.				
BL.				
L.	2792			Geol.
K.C.				Contr.
B.K.C.	3184			Sierra Drlg.
Ce.				
C.	3404			
M.				Pool
M.				Window
K.				
Mz.				
Ma.				
V.				
S.				
S.				
A.				
R.				
PE.				
G.				
T.D.	3451			

COMPLETE

NOV 6 57

Date Comm. _____
 Location AUG 28 57 8-21-57 858
176/150 @ 2750 SEP 4 57 DST
3405-10 0 p/hr 30' 150 CM
BITPZ @ 5 1/2" 3450 SEP 11 57
WACT SEP 18 57 MICT SEP 27 57
CO 3420 36/3400-06 10 1/2 g W
ph 4 hrs ss sd r vac
39 BA PH 10 1/2 hrs 11 hrs
3 1/2 BIT PH 10 1/2 W no POP

30-19-5W

N/2 N/2 SW

OCT 2 '57

OCT 9 '57

W o tubing

OCT 15 '57

OCT 22 '57 OCT 30 '57

POT P 11280 + 990 W
35.3°gr

30-19-5W

ms 2/2 2/2

County McPherson Elev. _____
 Sec. 28 Twp. 19 Rge. 5W
 Company Oil Trading
 Farm Name Geiman No. 3

TOPS	DEPTH	LOG	DATUM
Anh.			
Tp.			
H.			
Tr.			
Dg.			
Bl.			
L.			
K.C.			
B.K.C.			
Ce.			
C.			
M.			
M.			
K.			
Mz.			
Mo.			
V.			
S.			
S.			
A.			
R.			
Pe.			
G.			
T.D.			

Loc. in Sec. N/2 N/2 SW
 Geol. _____
 Contr. Sierra Drlg.
 Pool Windom



Date Comm. _____
 Location _____

11

Co.
Lse.
No.
Sec.
T.
R.