

Pawnee

KANSAS

25

20

20W

SECTION _____ TOWNSHIP _____ RANGE _____

#1 Newsom

WELL NO. _____

Honaker-Davis Drlg.

COMPANY _____

NORTH

						0	

WEST

EAST

SOUTH

Pawnee

KANSAS

SEC.	TWP.	R.
25	20	20W

WELL NO. #1 Newsom FARM

COMPANY Honaker-Davis Drlg


CONTRACTOR Co Tools
Wildcat

_____ FT. FROM N. LINE

_____ FT. FROM S. LINE

_____ FT. FROM E. LINE

_____ FT. FROM W. LINE

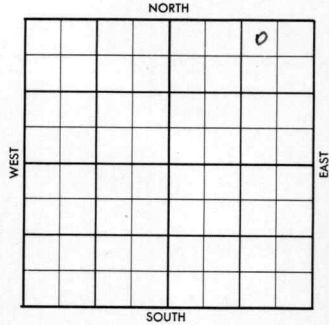

NW NE NE

1956	ELEVATION	REPORT
------	-----------	--------

9-5 Loc

County Pawnee Elev. _____
Sec. 25 Twp. 20 Rge. 20W
Company Honaker-Davis Drlg.
Farm Name Newson No. 1

TOPS	DEPTH	LOG	DATUM	Loc. in Sec.
Anh.				NW NE NE
TP.				
H.				
Tr.				
Dg.				
BL.				
L.				Geol. _____
K.C.				Contr. _____
B.K.C.				Co. Tools
Ce.				Pool
C.				Wildcat
M.				
M.				
K.				
Mz.				
Me.				
V.				
S.				
S.				
A.				
R.				
Pe.				
G.				
T.D.				

Date Comm. _____
Location 14

Marked by mistake

County Pawnee Elev. 2213
 Sec. 25 Twp. 20 Rge. 20W
 Company Honaker-Davis Drig.
 Farm Name Newsom No. 1

TOPS	DEPTH	LOG	DATUM	Loc. in Sec.
Anh.	1345			NW NE NE
Tp. <u>ETR14</u>	2360			
H.	3663			
Tr.				
Dg.				
BL.				
L.	3712			Geol.
K.C.				Concr.
B.K.C.				
Ce.				Co. Tools
C.	4154			
M. <u>Cesd</u>	4210-18			Pool <u>Newsom</u>
M. " "	4233-38			<u>Wildcat</u>
K. <u>Miss chert</u>	4268			
Mz. <u>Cg</u>	4254			
Me. <u>Kdsd</u>	4395			
V.	4404			
S.				
S.				
A.				
R.				
PE.				
G.				
TD.	4428			

NOV 23 '56
 COMPLETE

Date Comm.

Location SEP 12 '56 9-6-568578 429 / 300 2761 SEP 19 '56DST 4193-4206 30" rec 10' MdBHP 0/30" DST 4203-20 or1hr Gas ga 4 Mill rec 450'SW Tool plgd. no BHP SEP 26 '56X DST 4231-40 or 15" G/I" ga.A. 260 MCF BHP 1350/20 DST 4231-40 or 70" ga 3. 880 MCF/20"

stabil. rec 5' Mud BHP 1360/20"
 DST 4270-80 or 1hr 1900' GIP
 rec 90' GCMO + 135' CCO gran
 34° + 15' Wtr. BHP 1190/30"
 DST 4280-90 1hr 2370' GIP
 rec 35' ~~145' GCM~~ + 205' CCO BHP
 1070/20" DST 4292-4305 or
 1hr rec 240' SW BHP 1320/30"
 ID 4325 ~~DST 4231-40 15"~~
~~DST 4232-40 70" G/2" ga~~
~~3,880 MCF BHP 1360/30"~~
 5 1/2 4361/150 OCT 3 '56 28/4270
 -78 & 3/4 Boph 1/2 & 4
 Boph 9 hrs. Gas broke in
 to 5 q OCT 10 '56 CO OCT 17 '56 X PBD
 4282 sqd 4270-78 w/sd. PF
 4264-66 sqd w/cem. CO 4282
 Frac. 7 BFph 5090 oil no time
 T&R wo pump unit. OCT 24 '56 P.
 26 Bo + 77% wtr 24 hrs
 gran 37° OCT 31 '56 OCT 7 '56 X P.
 25 Bopd + 75% wtr. (steady).
 (Bad cem. job. Leave it as is
 as long as it holds up) needs
 st. Pot. (sq chart rec) NOV 13 '56
 NOV 21 '56 P. 25 Bopd + 75
 % wtr gran 37°