
FORM 51

Ness KANSAS

Section 31 Township 20 Range 22W

Well No. #1 Foos

Company M.B. Armer.

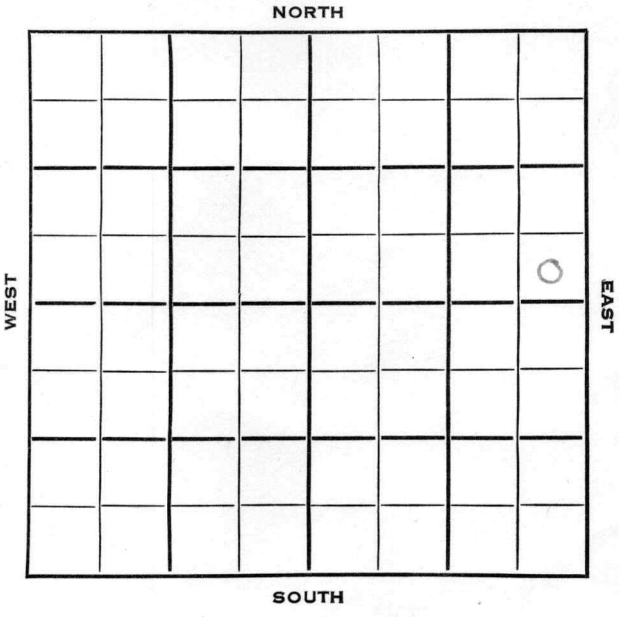

FORM 252-B
10M 10-50 PETROL

Ness

KANSAS ✓

Sec. 31 Twp. 20 R. 22W

Well No. #1 Foos Farm

M.B. Armer Company

Todd Drlg. Contractor

Wildcat.

Ft. from N. Line


330 Ft. from S. Line

330 Ft. from E. Line

Ft. from W. Line

SE SE NE

Carter & Mag. (AC & DHM)

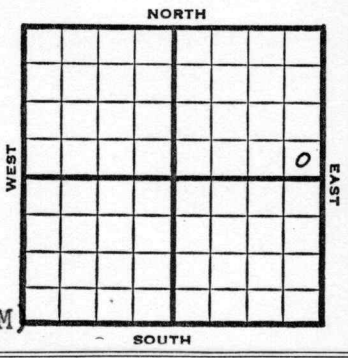

1953	Elev. 2215' REPORT
4/29	M I R
5/7	8" @ 221' Anhy 1465' Drlg 2220'
5/20	Spud 5-1-53 D&A TD 4507 8" @ 221 Anhy 1465, Heeb 3742, Lans 3790, Miss 4407 TD 4507 D&A

ABANDONED

FORM 275 FOR SALE BY KANSAS BLUE PRINT CO.


County Ness State Kansas

Sec. 31 (Blk. Twp.) 20 (Sur. Rge.) 22W Map No.

Operator M. B. Armer

Well No. 1 Farm Foos

Elev. Location SE SE NE

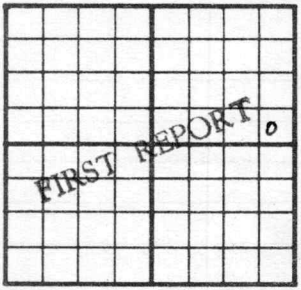

330 Ft. From S Line NE

330 Ft. From E Line Quarter

APR 29 1953

1st. Report

Completion

Remarks Carter & Mag.(AC & DHM)
Todd Drlg. - Contr.

Spudding Date

Drlg. Data Wildcat

M I R

J. G. McGEHEE

FORM 275 FOR SALE BY KANSAS BLUE PRINT CO.


County Ness State Kansas

Sec. 31 (Blk. Twp.) 20 (Sur. Rge.) 2 2W Map No.

Operator M. B. Armer

Well No. 1 Farm Foos

Elev. 2215 Location SE SE NE

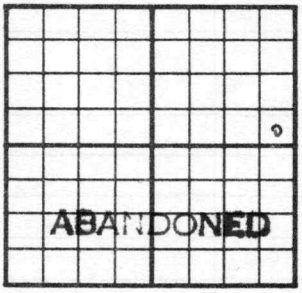

330 Ft. From S Line NE

330 Ft. From E Line Quarter

1st. Report

Completion MAY 20 1953

Remarks Wildcat

Spudding Date 5-1-53

Drlg. Data D & A TD 4507

8" @ 221 Anhy 1465 Heeb. 3742

Lans. 3790 Miss. 4407 TD 4507

D & A

J. G. McGEHEE