


Section 18 Township 20 Range 21W

Well No. #1 Schwein

Company Pabco Drlg.

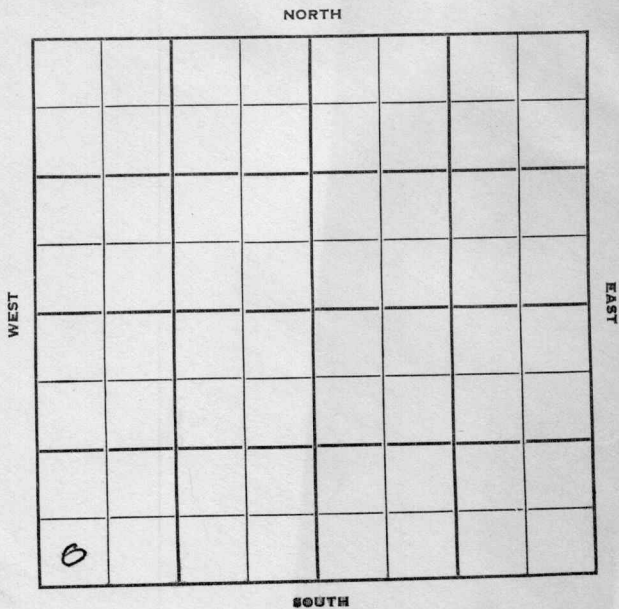

Sec. _____ R. _____

Well No. # 1 Schwein Farm

Pabco Drlg. Company

~~Pabco~~ B & R Drlg. Contractor

Wildcat

_____ Ft. from N. Line

330 _____ Ft. from S. Line


_____ Ft. from E. Line

330 _____ Ft. from W. Line

SW SW SW

MCPC has S/2 of 9

Texas, Sun, Sinclair DHM

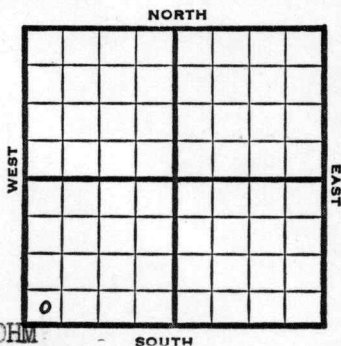

1951 Elev. 2211' REPORT

11/14	Location	
11/30	"	(Ltr)
12/7	"	"
1952		
1/4	Spudded 12-18-51 Set 8" @ 240'. Drilling at 3500'	"
1/11	Heeb 3715' Lans 3763' Marm. 4056' DST 4296-4353' open 1 hr. rec 10' mud. Cong. 4302' DST 4335-45', test mud & SSO, Miss 4360' DST 4360-70', open 1 hr. rec 30' mud. DST 4371-4407', open 25 min, rec 5' mud plus 85' mud & salt water, 1400' water. Drilling at 4440'	(Ltr)
1/17	Gilmore City 4470' TD 4512' D & A	"
1/16	Spud 12-18-51 D & A TD 4512' 8" @ 240' Heeb 3715' Lans 3763' Marm. 4056' Cong. 4302' DST 4296-4353' open 1 hr, rec 10' mud	

OVER

1952
1/16

(Information continued)

DST 4335-45, test mud & SSO

Miss 4360'

DST 4360-70 open 1 hr, rec 30' mud

DST 4371-4407 open 25 min, rec 5' mud
85' mud & SW, 1400' water.

Gilmore City 4470'

TD 4512' D & A

ABANDONED

