KANSAS

FORM 51 5M 10-41 PETROL


Rice

Section 3 Township 19 Range 6-W

Well No. #1 Appel

Company Westgate-Greenland

Wildcat

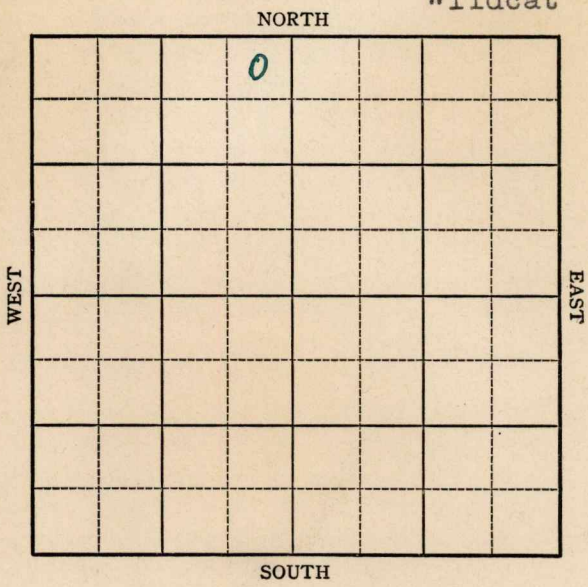

Form 252-A
5M 5-42 Petrol

KANSAS

Rice

Sec. 3 Twp. 19 R. 6-W

Well No. #1 Appel Farm

Westgate - Greenland Company


(Wildcat)

330 Ft. from N. Line

Ft. from S. Line

330 Ft. from E. Line

Ft. from W. Line

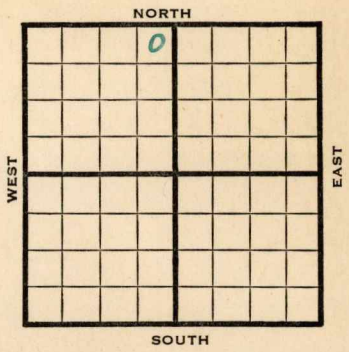

Elev. 1656

1942	REPORT
7/1	Surface pipe.
7/8	Lans. 2793' Miss. 3355' Drlg. 3383'
7/15	Miss. 3355' T.D. 3437' No shows.

ABANDONED

Form 26 200 Bks. 5-41 McW.

Rice

KANSAS

Map No. 48 Sec. 3 Twp. 19 R. 6W

Well No. 1 Appel

WEstgate-Greenland Company

FIRST REPORT Contractor

NE NW

330 Ft. from N. Line


Ft. from S. Line

330 Ft. from E. Line

Ft. from W. Line

WILDCAT

SECTION PLAT

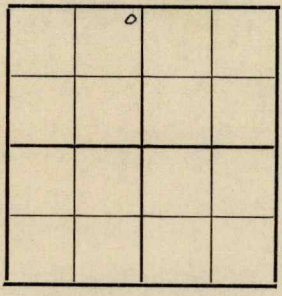

Location

Rig up

Drilling and Remarks:

Surface Pipe

RECORD

Cased in., ft.

Sand

Gas

Oil

Total Depth

PRODUCTION

1st 24 hrs. Nat.

1st 24 hrs. after shot

Gas Cu. Ft.

Dry Hole

Abandoned

Date

JUL 1 1942

19

S. J. LEWIS Scout

Form 26 200 Bks. 5-41 McW. Rice KANSAS

Map No. 48 Sec. 3 Twp. 19 R. 6W

Well No. 1 Appel

Westgate-Greenland Company

ABANDONED Contractor

NE NW


330 Ft. from N. Line

_____ Ft. from S. Line

330 Ft. from E. Line

_____ Ft. from W. Line

SECTION PLAT

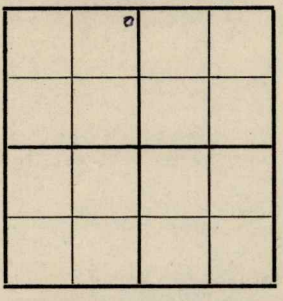

WILDCAT

Location _____

Rig up _____

Drilling and Remarks:

Miss 3355

Nowata

RECORD

Cased _____ in., _____ ft.

Sand _____

Gas _____

Oil _____

Total Depth 3487

PRODUCTION

1st 24 hrs. Nat. _____

1st 24 hrs. after shot _____

Gas _____ Cu. Ft.

Dry Hole _____

Abandoned _____

Date

JUL 15 1942 19

S. J. LEWIS Scout