

Ness

KANSAS

1


20

26W

SECTION _____ TOWNSHIP _____ RANGE _____

WELL NO. #1 Beetz

COMPANY N.C.R.A

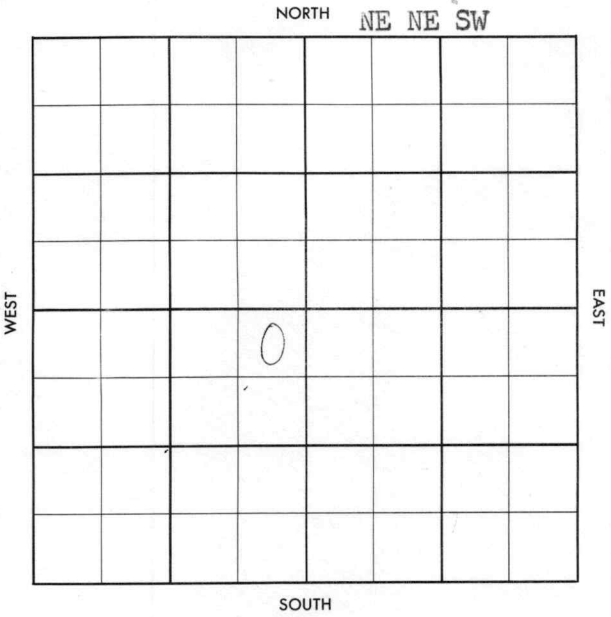

Ness

KANSAS

SEC.	1	TWP.	20 S	R.	26 W
------	---	------	------	----	------

WELL NO.

1 Beetz

FARM

COMPANY

N.C.R.A

CONTRACTOR

Lewis Drlg.


Wildcat

_____ FT. FROM N. LINE

_____ FT. FROM S. LINE

_____ FT. FROM E. LINE

_____ FT. FROM W. LINE

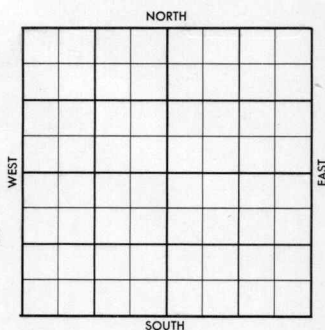

NE NE SW

SDX-1/2 Mile

1957

ELEVATION

REPORT

B/6

Comm. 3-3-57
8" @ 772/475 WOC

(FR Tkt)

WILDCAT

FORM 513 SUNRAY

County Ness Elev. _____
 Sec. 1 Twp. 20 Rge. 26W
 Company N. C. R. A.
 FarmName Beetz No. 1

TOPS	DEPTH	LOG	DATUM
Anh.			
Tp.			
H.			
Tr.			
Dg.			
BL.			
L.			
K.C.			
B.K.C.			
Ce.			
C.			
M.			
M.			
K.			
Mz.			
Me.			
V.			
S.			
S.			
A.			
R.			
Pe.			
G.			
T.D.			

Loc. in Sec. _____

NE NE SW

Geol. _____

Contr. _____

Lewis Drlg

Pool _____

Wildcat

FIRST REPORT

SDX-

0
 1/2 mi.
 MAR 6 57

Date Comm. 3-3-57

8" @ 772/475, WOC

MAR 11 1957

M.M.

4568
2541
-2027

FORM 513 SUNRAY

County Ness Elev. 2541
Sec. 1 Twp. 20 Rge. 26W
Company N. O. R. A.
Beetz No. 1

	DEPTH	LOG	DATUM	Loc. in Sec.
Top				NE/NE SW
H.	3890	3892		
Tr.		3912		
Dg.				
Bl.				
L.	3933	3935		Geol.
K.C.				
B.K.C.		4312		Contr.
Ce. <u>Martin</u>		4360		
C.	4518	4513		Lewis Drilg.
M.	4533	4568		
M.				Pool
K.				Wildcat
Mz.				
Mo.				
V.				
S.				
S.				
A.				
R.				
Pe.				
G.				
TD.	4690			

ABANDONED

MAR 27 '57

Date Comm. 3-3-57
8" @ 772/475, WOC MAR 13 '57 03855 MAR 20 '57
DST 4518-32 90" rec 180' SW
FP 30-100 BHP 1360/30"
DST 4532-43 1 hr rec 15' Md
BHP 320/20 Rng Log. MAR 27 '57

D&A