


Section 16 Township 20 Range 26W
Well No. 1 Jones
Company M. B. Armer

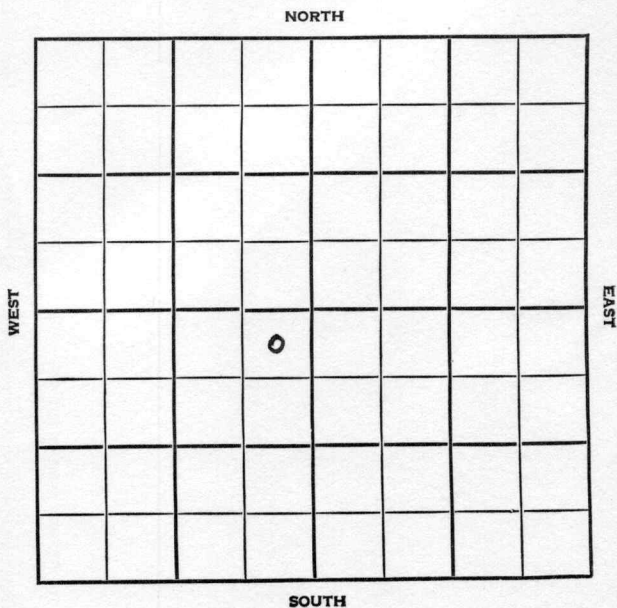

Ness KANSAS

SEC.	TWP.	R.
16	20	26W

WELL NO.

1 Jones

FARM

COMPANY

M. B. Armer

CONTRACTOR

Co. Tools


Wildcat

330 Ft. from N. Line

Ft. from S. Line

330 Ft. from E. Line

Ft. from W. Line

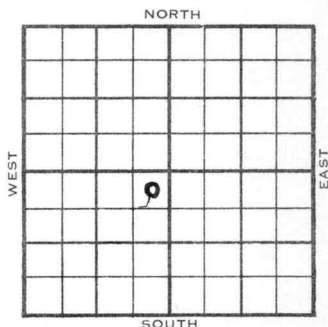

NE NE SW
Phillips DHM

1955

ELEVATION

REPORT

4/20

Spud 4-17-55
8" @ 285'
Anhy 1225'
Drlg. 2245'

County **Ness** State **Kansas**

Sec. 16 (Blk.) 20 (Sur.) 26W Map No.

Operator M. B. Armer

Well No. **1** Farm **Jones**

Elev.	Location	NE	NE	SW
-------	----------	----	----	----

A 10x10 grid with a vertical line down the center. A small circle is in the 5th row, 4th column. A diagonal stamp reads "FIRST REPORT".

330 Ft. From N Line SW

330 Ft. From R Line Quarter

1st. Report APR 20 1955

Completion

Remarks Phillips - DHM

Co. tools

Spudding Date 4-17-55

Drig. Data Wildcat

8" @ 285 Anhy 1225 drlg. 2245

FABEN GILSTRAP