


LOCATION NOTICE

TULSA, OKLA., November 27, 19 42

WELL NO. One (1) ON Melvin Harrison FARM

WILL BE AS FOLLOWS:

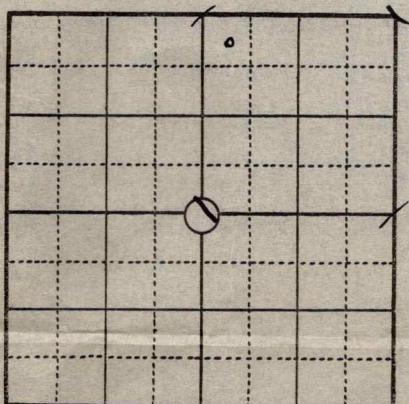

330 FEET FROM NORTH LINE

FEET FROM EAST LINE

FEET FROM SOUTH LINE

330 FEET FROM WEST LINE

IN NE 1/4 SEC. 19 TWP. 20S RANGE 13W

Barton COUNTY, STATE OF Kansas

REMARKS: Mid-Continent Petroleum Corp. one-half interest
Palmer Oil Corp. one-half interest - Operator

SIGNED [Signature]

COPIES TO

DISTRICT SUPT.
 ACCOUNTING DEPT.
 RENTAL DEPT.
 SCOUTING DEPT. ✓
 ENGINEERING DEPT.
 LEGAL DEPT.
 LEASE INVENTORY
 CLAIM DEPT.
 TAX DEPT.
 GEOLOGICAL DEPT.
 FILE
 PURCHASING DEPT.