

1st 24 hrs. Nat. _____
1st 24 hrs. after shot _____
Gas _____ cu. ft. _____
Dry Hole _____
Abandoned _____

Map No. KANSAS Sec. 16 Twp. 20 R. 31^W

Well No. 1-5 Farm Peters

Wry Lake Enterprise Company


1320 Ft. from N. Line

_____ Ft. from S. Line

_____ Ft. from E. Line

1320 Ft. from W. Line

1930

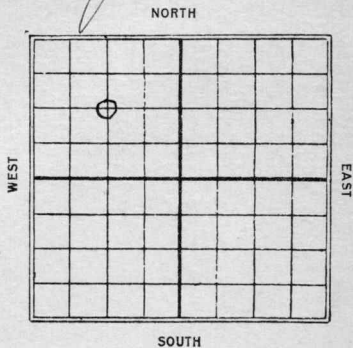

Date

REPORT

1/29 Pillar

2/5 —

2/12 —

2/19 —

2/26 —

3/5 —


3/12 —

3/19 Abandon loc.

Map No. 16 Sec. 16 Twp. 20 R. 21WWell No. 1 PetersTray Lake Enterprise Company

Contractor

SECTION PLAT

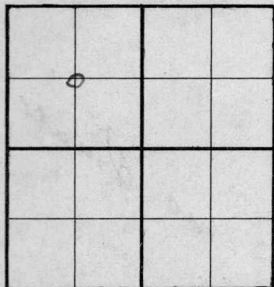1320 Ft. from N. Line

_____ Ft. from S. Line

_____ Ft. from E. Line

1320 Ft. from W. Line

FIRST REPORTS

Location _____

Rig up _____

Drilling and Remarks:

Cellar

RECORD

Cased _____ in., _____ ft.

Sand _____

Gas _____

Oil _____

Total Depth _____

PRODUCTION

1st 24 hrs. Nat. _____

1st 24 hrs. after shot _____

Gas _____ Cu. Ft.

Dry Hole _____

Abandoned _____

Date

JAN 29 1930

19

S. J. LEWIS Scout

Map No. KANSAS Sec. 16 Twp. 20 R. 21W

Well No. 1 Peters

Dry Lake Enterprise Company
Contractor


SECTION PLAT

1320 Ft. from N. Line

..... Ft. from S. Line

..... Ft. from E. Line

1320 Ft. from W. Line

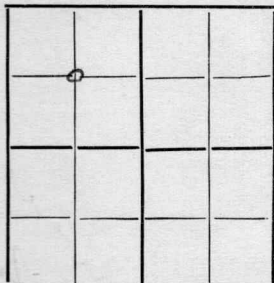

ABANDONED

Location.....

Rig up.....

Drilling and Remarks:

De la R.

RECORD

Cased.....in.,ft.

Sand.....

Gas.....

Oil.....

Total Depth.....

PRODUCTION

1st 24 hrs. Nat.....

1st 24 hrs. after shot.....

Gas.....Cu. Ft.

Dry Hole.....

Abandoned.....

Date

MAR 19 1930

S. J. LEWIS

Scout