


Map No. KANSAS Sec. 14 Twp. 20 R. 33-W
 Well No. #1 Mark "B" Farm _____
Atlantic Oil & Prod. Company _____

NORTH

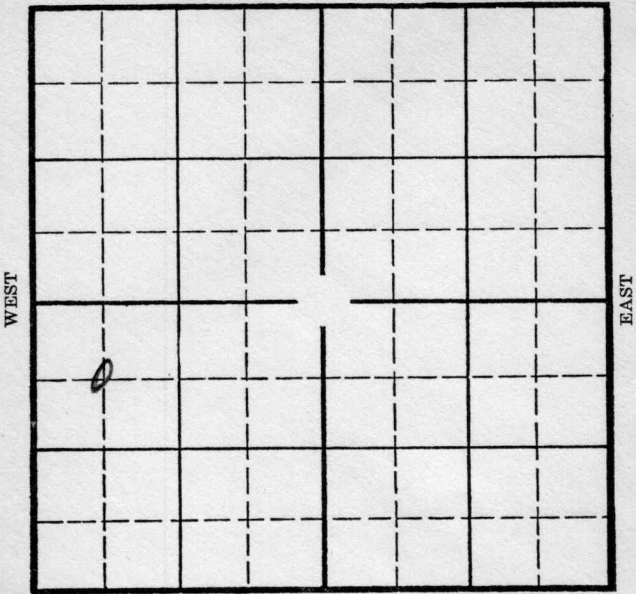

SOUTH

Location _____
 Drilling Remarks _____

Rig Up _____
 Drilling Remarks _____

RECORD

Cased _____ in. _____ ft.
 Sand _____
 Gas _____
 Oil _____
 Total Depth _____


PRODUCTION

1st 24 hrs. Nat. _____
 1st 24 hrs. after shot _____
 Gas _____ cu. ft. _____
 Dry Hole _____
 Abandoned _____

Map No. 14 Sec. 20 Twp. 33W
Well No. 1-Mark 'B' Farm
Atlantic Oil & Prod. Company

660 Ft. from N. Line
Ft. from S. Line
Ft. from E. Line
660 Ft. from W. Line

Elev. 2946

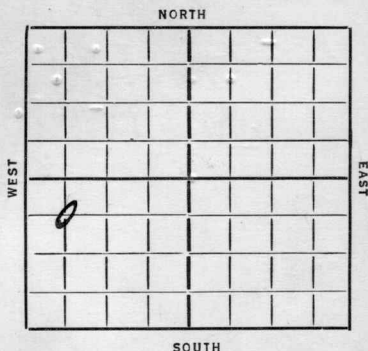

Date

REPORT

2/26	Location
2/27	--
2/28	Log
3/6	Run
3/13	Spud
3/20	--
3/27	12" - 254' Drlg. 2690'
4/2	Drlg. 3085'
4/10	Drlg. 3680'
4/16	3720' Fishing.
4/23	Drlg. 3810'
4/30	Drlg. 4358'
5/7	Drlg. 4597'.
5/14	--
Top Miss. Lime.	
5/21	Top Miss. Lime. 4610'. Pay 4633-49' 3200' oil in hole. Swab 50 bbls per hour for 8 hours. 27 gr.
5/28	No test.
6/4	Shut down.
6/11	-- 6/18--

OVER

6/25-Notest.--

7/2--7/9--7/16--7/23-7/30--

8/5/36-Top Miss. L. 4610'.

T.D. 4649'.

Pay 4633-49'.

1000 gallons of acid.

Pot. 1177 bbls of oil.

COMPLETED

KANSAS

Map No. No Map Sec. 14 Twp. 20 R. 33^N

Well No. 1-Mark B'

Atlantic Oil & Prod Company

Contractor

FIRST REPORTS.

SECTION PLAT

660 Ft. from N. Line

..... Ft. from S. Line

..... Ft. from E. Line

660 Ft. from W. Line

0			

Location ✓

Rig up

Drilling and Remarks:

RECORD

Cased in., ft.

Sand

Gas

Oil

Total Depth

PRODUCTION

1st 24 hrs. Nat.

1st 24 hrs. after shot

Gas Cu. Ft.

Dry Hole

Abandoned

Date

ORVAL MANNSCHRECK

2-12-36 192..... Scout

KANSASMap No. No Maps Sec. 14 Twp. 20 R. 33W.Well No. 1 Stark "B"Atlantic Oil Prod. Company

Contractor

SECTION PLAT

0			

660 Ft. from N. Line

_____ Ft. from S. Line

_____ Ft. from E. Line

660 Ft. from W. Line**COMPLETED**

Location _____

Rig up _____

Drilling and Remarks:

Top Miss L. 4610Pay 4633.-49PooodacidPa 8 1177**RECORD**

Cased _____ in., _____ ft.

Sand _____

Gas _____

Oil _____

Total Depth 4649**PRODUCTION**

1st 24 hrs. Nat. _____

1st 24 hrs. after shot _____

Gas _____ Cu. Ft.

Dry Hole _____

Abandoned _____

Date

AUG 5 1936₁₉**S. J. LEWIS**

Scout