


Scott

Section 11 Township 20 Range 33W **KANSAS**

Well No. #1 Wasinger

Company Shallow Wtr Ref.

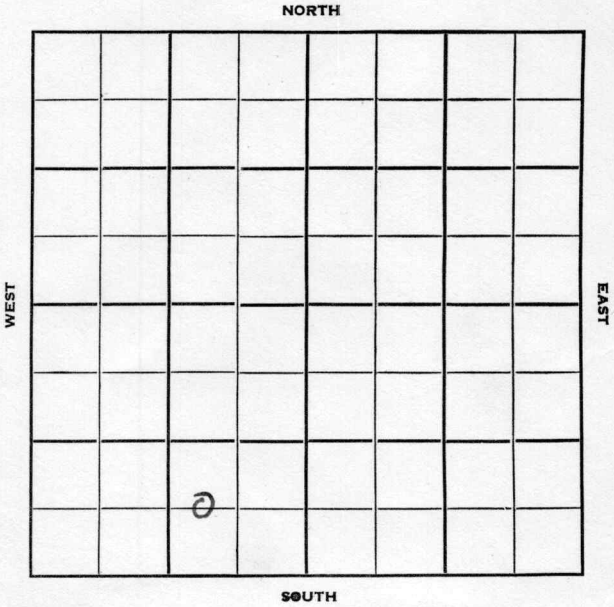

Sec. 11 Twp. 20 R. 33 W

Well No. # 1 Wasinger Farm

Shallow Water Ref. Company

Barnett Drlg. Contractor


 Ft. from N. Line

660 Ft. from S. Line

990 Ft. from E. Line

 Ft. from W. Line

C W L SE SW

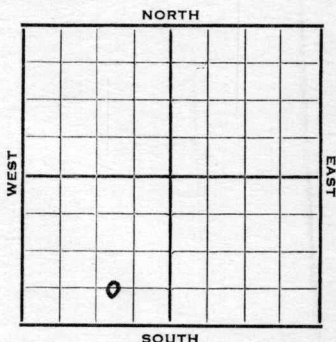

1952	Elev. 2942'	REPORT
7/9	Spud 7-2-52 8" @ 270 Anhy 2120' Drlg. 2440'	
7/17	Heeb 3791' Lans. 3807' KC 3839' Drlg. 3900'	
7/23	Marm 4260 F 4280-91 F 4291-99 F ahead	
7/30	Miss 4605 RTD 4651 5" @ 4640'	
8/6	NR	
8/13	NP	
8/20	CO 4651 1 galo & 1 galwph 500 A 6 BO & 6 BWPH for 24 hrs. 2000 A	
8/27	S/ 8 BO & 8 Bwpd	
9/3	5000 A No help S/8 BO & 8 BWPD	
9/10	NR	
9/17	"	
9/24	"	
10/1	"	
10/8	"	
10/15	"	
10/22	"	

OVER

1952
10/29 NR
11/5 "
11/22 "
11/20 "
11/27 "
12/3 Spud 7-2-52
Oil Well
TD 4651
8" @ 270
Anhy 2120, Heeb. 3791', Lans
3807', KC 3839', Marm 4260,
Miss 4605
TD 4651
5" @ 4640
CO to 4651 1 go 1 gwph 500A
6 bo 6 bwph 2000A
S/8 bo 8 bwph 5000A
P/8 bopd 8 bw
Comp. 8 bopd 8 bw

COMPLETED

County Scott State Kansas

Sec. **11** (Blk. Twp.) **20** (Sur. Rge.) **33W** Map No.

Operator Shallow Water Ref.

Well No. 1 Farm Wasinger

Elev.	2942	Location	C W L S E S W
-------	------	----------	---------------

FIRST REPORT

660 Ft. From S Line SW

990 Ft. From **E** Line Quarter

1st. Report JUL 9 1952

Completion

Remarks

Barnett D.,lg. - Contr.

Spudding Date 7-2-52

Drlg. Data

8" @ 270 Anhy 2120 drlg. 2440

J. G. McGEHEE

11

2

COMPLETE

990 Ft. From E Line Quarter

Completion DEC 3 1952

Barnett Drlg. - Contr.

Spudding Date 7-2-52

Drbg. Data

8"

Lan

Mis

465

2000

P/