


KANSAS

Scott County

Section 14 Township 20 Range 33W

Well No. #1 M. Bague

Company F. G. Hall & Hag.

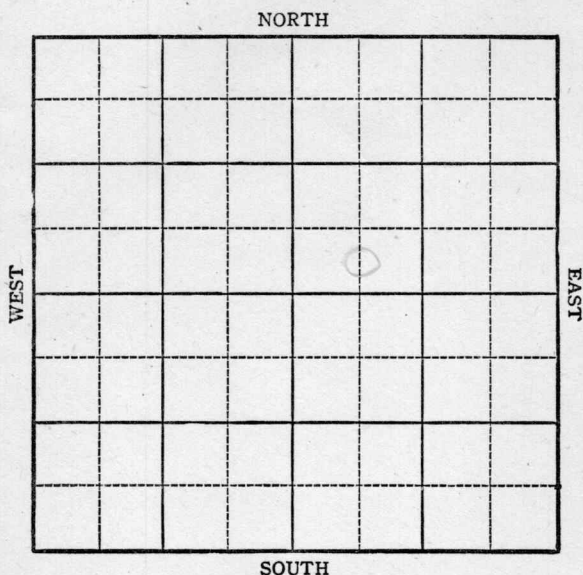

KANSAS

Scott County

Sec. 14 Twp. 20 R. 33W

Well No. #1 M. Bague Farm

F. G. Hall & Hag. Company


Shallow Water

Ft. from N. Line

330 Ft. from S. Line

Ft. from E. Line

660 Ft. from W. Line

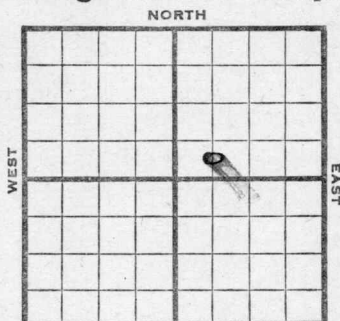

CSL SW NE

E lev 2929

1944

R E P O R T

10/18	Rotary
10/25	10" @ 240 WOC
11/1	Drlg. 2275
11/8	Drlg. 3000
11/16	Drlg. 3990'
11/24	Miss 4591 5" @ 4068 TD RUST
11/29	" " " " " " " " "
12/6	" Drlg. 3000" " " " " " " "
12/14	Drlg. 4692' no shows
12/21	TD 4705
	140 gts
	4624-4684 CO
12/29	" " "
<u>1945</u>	
<u>1/3</u>	SSO fsg bailer
1/10	" " "
1/17	Miss 4591
	5" @ 4608
	3000 acid
	TD 4705

ABANDONED

KANSAS

Pool Name Shallow WaterMap No. V 11 Sec. 14 Twp. 20 R. 33WWell No. 1 M. BagueF. G. Hall & Hag.


Company

FIRST REPORT

Contractor

C S L SW NE

SECTION PLAT

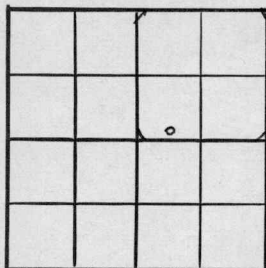 Ft. from N. Line330 Ft. from S. Line Ft. from E. Line660 Ft. from W. LineScottLocation Rig up Drilling and Remarks:
Rotary

RECORD

Cased in., ft.Sand Gas Oil Total Depth

PRODUCTION

1st 24 hrs. Nat. 1st 24 hrs. after shot Gas Cu. Ft.Dry Hole Abandoned

Date

OCT 1 8 1944 19S. J. LEWIS Scout

Pool Name Shallow Water

KANSAS

Map No. _____ Sec. 14 Twp. 20 R. 33WWell No. 1 M. DagueF. G. Holl & Hay CompanyABANDONED Contractor

C S I S W NE

SECTION PLAT

		0	

_____ Ft. from N. Line

330 Ft. from S. Line

_____ Ft. from E. Line

660 Ft. from W. Line

Scott

RECORD

Location _____

Cased _____ in., _____ ft.

Rig up _____

Sand _____

Drilling and Remarks:

Gas _____

Oil _____

Total Depth 4705

PRODUCTION

1st 24 hrs. Nat. _____

1st 24 hrs. after shot _____

Gas _____ Cu. Ft.

Dry Hole _____

Abandoned _____

Date

JAN 17 1945 19S. J. LEWIS

Scout

Miss 4591
5-1104608.
3000 acid