Scott


Form 51—5M—5-34—Palace

KANSAS

Map No. ____ Sec. 14 Twp. 20 R. 33 W

Well No. 1 Dague Farm

Atlantic Oil Prod Company

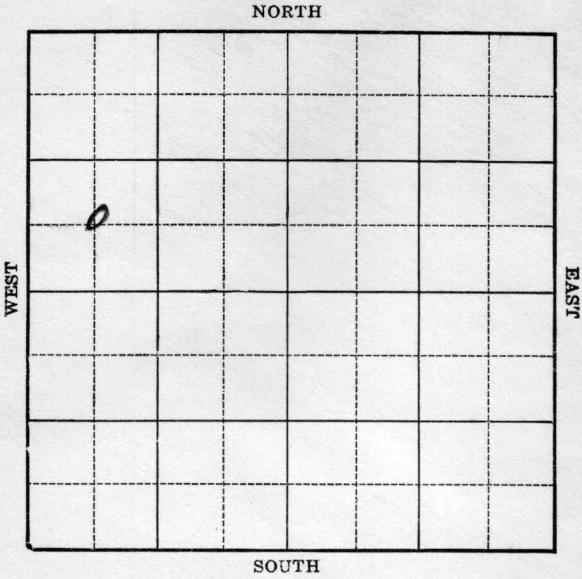

Location

Drilling Remarks

Rig Up

Drilling Remarks

RECORD

Cased ____ in. ____ ft.

Sand

Gas

Oil

Total Depth

PRODUCTION

1st 24 hrs. Nat.

1st 24 hrs. after shot

Gas ____ cu. ft.

Dry Hole

Abandoned


Form 252-A
5M 7-34 MPC

Scott

Map No. KANSAS Sec. 14 Twp. 20 R. 33W

Well No. 1- Dague Farm

Atlantic Oil Prod. Company

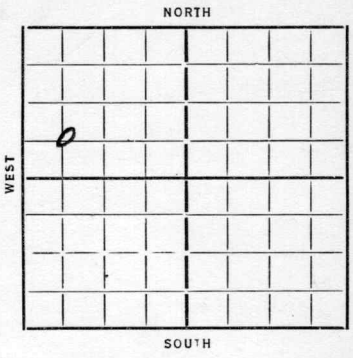

_____ Ft. from N. Line

660 Ft. from S. Line

_____ Ft. from E. Line

660 Ft. from W. Line

Date	REPORT
1935	
4/24	B. R.
5/4	Rig
5/9	Spud
5/16	Dlg 2300 15" 240
5/22	" 3225
5/29	Dlg 3630 Core 4
6/6	Dlg
6/13	Dlg 3817
6/20	— 6/28 — 7/3 — 7/11 —
7/18	—
8/1	TML 4629 Core 4646
	Saturation 4633-44
	7" 4622 Rest
8/8	—
8/15	Swab 71 Bbls 3 hrs.
8/22	Shot 30 qts Swab 30 Bbls
	per hr Tubing
8/29	1500 acid P 2236 Bbls 4 hrs
	24 Hrs.
9/6	4646 TD S.D.
9/25	Miss L. 4629 TD 4646
	731 Bbls 15 hrs.

COMPLETED

Form 26-1M Bks. 9-28

KANSAS

Map No. No Map Sec. 14 Twp. 20 R. 33W


Well No. 1 - Hague

Atlantic Oil Prod Company

Contractor

FIRST REPORT

SECTION PLAT

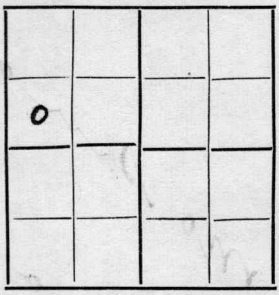

Ft. from N. Line

660 Ft. from S. Line

Ft. from E. Line

660 Ft. from W. Line

Location

Rig up

Drilling and Remarks:

BR

RECORD

Cased in., ft.

Sand

Gas

Oil

Total Depth

PRODUCTION

1st 24 hrs. Nat.

1st 24 hrs. after shot

Gas Cu. Ft.

Dry Hole

Abandoned

Date

4-27-35 192

ORVAL MANNSCHRECK Scout

Form 26—1M Bks.—9-26

KANSAS

Map No. N.M. Sec. 14 Twp. 20 R. 33W


Well No. 1-Dague

Atlantic Oil prod Company

Contractor

COMPLETED

SECTION PLAT

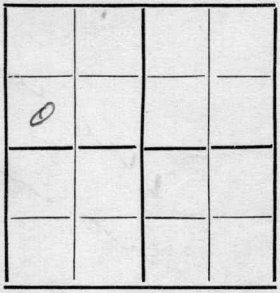

Ft. from N. Line

660 Ft. from S. Line

Ft. from E. Line

660 Ft. from W. Line

Location

Rig up

Drilling and Remarks:

731 bbls
15 hrs

RECORD

Cased in, ft.

~~Sand~~ Miss L. 4629

Gas

Oil

Total Depth 4646

PRODUCTION

1st 24 hrs. Nat.

1st 24 hrs. after shot

Gas Cu. Ft.

Dry Hole

Abandoned

Date

9-25-35 192

ORVAL MANNSCHRECK Scout