Form 51-5M 5-37 Petrol


Scott

KANSAS

Section 14 Township 20 Range 33-W

Well No. 2 - Dague

Company Atlantic

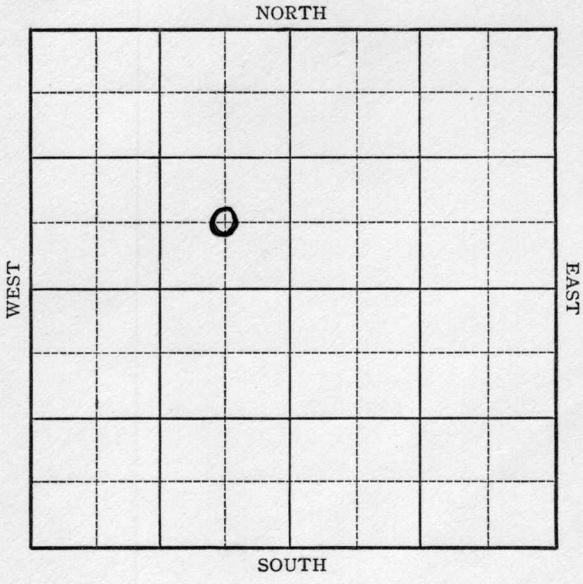


Form 252-A—5M—2-37—Palace Scott KANSAS

Sec. 14 Twp. 20 R. 33-W

Well No. #2 Dague Farm

Atlantic Company

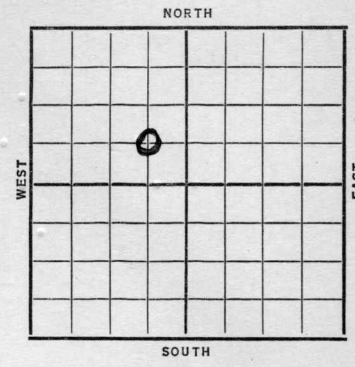

____ Ft. from N. Line

660 Ft. from S. Line

660 Ft. from E. Line

____ Ft. from W. Line

Elev. 2937

Date	REPORT
1937	
8/4	Cellar
8/13	13" @ 250'. Drlg. 2890'.
8/20	Drlg. 3970'.
8/28	K.C. 3940'. S.O. 4225 &
	4295 & 4455'. Drlg. 4535'.
9/3	7" @ 4620'. Cored 4630-42'.
	3' Rec. saturated.
	Cored 4642-50' T.D. Rec. 3'
	sat. RUST.
9/10	Correction 4650 equal 4643'.
	T.D. 4644'. Swab 5 BOPH after
	head. Acidizing.
9/17	2000 acid. Swabbing 20 BOPH.
9/24	" " " " "
10/2	" " " " "

OVER

1937

10/6 7" @ 4620'.
Miss. 4595'.
T.D. 4644'.
2000 acid.
Potential 1149 bbls.

COMPLETED

Form 26—1M Bks.—2-29 Scott KANSAS

Map No. _____ Sec. 14 Twp. 20 R. 33 W

Well No. 2 - Dague

Atlantic Company

_____ Contractor

FIRST REPORT


_____ Ft. from N. Line

660 Ft. from S. Line

660 Ft. from E. Line

_____ Ft. from W. Line

SECTION PLAT

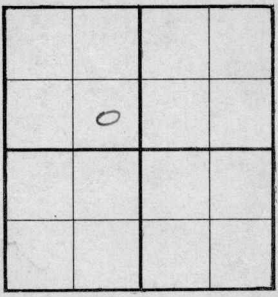

Location _____

Rig up _____

Drilling and Remarks:

cellar

RECORD

Cased _____ in., _____ ft.

Sand _____

Gas _____

Oil _____

Total Depth _____

PRODUCTION

1st 24 hrs. Nat. _____

1st 24 hrs. after shot _____

Gas _____ Cu. Ft.

Dry Hole _____

Abandoned _____

Date

AUG 4 - 1937 19 H. D. Hatfield Scout

Form 26—1M Bks.—2-29

Scott KANSAS

Map No. NM Sec. 14 Twp. 20 R. 33W

Well No. 2 Dague

Atlantic Company

Contractor

COMPLETED

C SE NW


_____ Ft. from N. Line

660 Ft. from S. Line

660 Ft. from E. Line

_____ Ft. from W. Line

SECTION PLAT

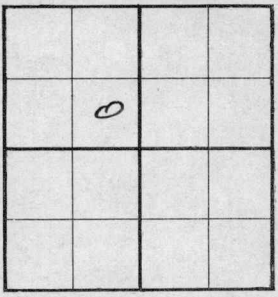

Location _____

Rig up _____

Drilling and Remarks:

2000 Acid

Pot - 1149

RECORD

Cased 7 in., 4620 ft.

Sand Miss 4595

Gas _____

Oil _____

Total Depth 4644

PRODUCTION

1st 24 hrs. Nat. _____

1st 24 hrs. after shot _____

Gas _____ Cu. Ft.

Dry Hole _____

Abandoned _____

Date

OCT - 6 1937 19

H. D. Hatfield Scout