


Section 14 Township ~~36~~ 20 Range 33-W

Well No. 2 - Pyle

Company Atlantic

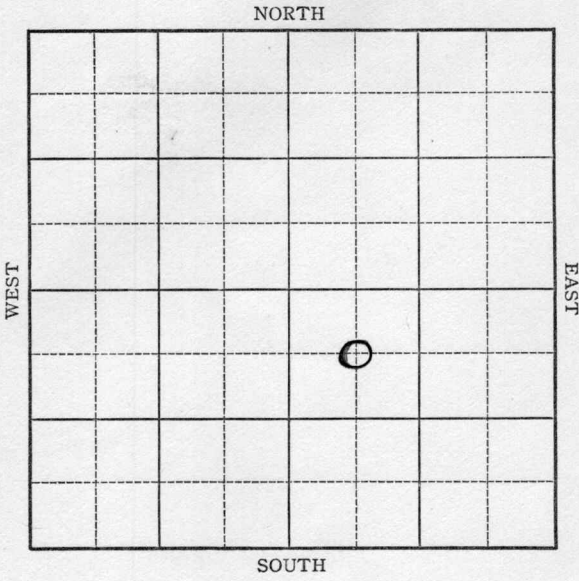

KANSAS

Map No. _____ Sec. 14 Twp. 20 R. 33WWell No. 2 - Pyle
Atlantic Company

Contractor _____

FIRST REPORT

SECTION PLAT

660 Ft. from N. Line

_____ Ft. from S. Line

_____ Ft. from E. Line

660 Ft. from W. Line

		0	

Location ✓

Rig up _____

Drilling and Remarks:

RECORD

Cased _____ in., _____ ft.

Sand _____

Gas _____

Oil _____

Total Depth _____

PRODUCTION

1st 24 hrs. Nat. _____

1st 24 hrs. after shot _____

Gas _____ Cu. Ft.

Dry Hole _____

Abandoned _____

Date

SEP 1 1937 19 H. D. Hatfield Scout

KANSAS

Map No. NN Sec. 14 Twp. 20 R. 33 WWell No. 2-Pyleatlantic Company

Contractor

CORRECTION

660 Ft. from N. Line

_____ Ft. from S. Line

_____ Ft. from E. Line

660 Ft. from W. Line

SECTION PLAT

		0	

Location _____

Rig up _____

Drilling and Remarks:

*Was first reported
as CNW SE of*

*14-30-33 W -
should have been
14-20-33 W*

RECORD

Cased _____ in., _____ ft.

Sand _____

Gas _____

Oil _____

Total Depth _____

PRODUCTION

1st 24 hrs. Nat. _____

1st 24 hrs. after shot _____

Gas _____ Cu. Ft.

Dry Hole _____

Abandoned _____

Date

SEP 27 1987

19

H. D. Hatfield

Scout

Scott

KANSAS

Map No. _____ Sec. 14 Twp. 20 R. 33WWell No. 2 PyleAtlantic

Company

Contractor

COMPLETED

C NW SE

660 Ft. from N. Line

_____ Ft. from S. Line

_____ Ft. from E. Line

660 Ft. from W. Line

SECTION PLAT

		0	

Location _____

Rig up _____

Drilling and Remarks:

5000 AcidPOT 1140

RECORD

Cased 7 in., 4636 ft.Sand MISS 4621

Gas _____

Oil _____

Total Depth 4687

PRODUCTION

1st 24 hrs. Nat. _____

1st 24 hrs. after shot _____

Gas _____ Cu. Ft.

Dry Hole _____

Abandoned _____

Date

NOV 10 193719H. D. Hatfield Scout