

KANSAS


Wichita county

FORM 51 IOM 12-46 PETROL

Section 21 Township 20 Range 35-W

Well No. #1, Henry Fee (Strat East)

Company Gulf Oil Company

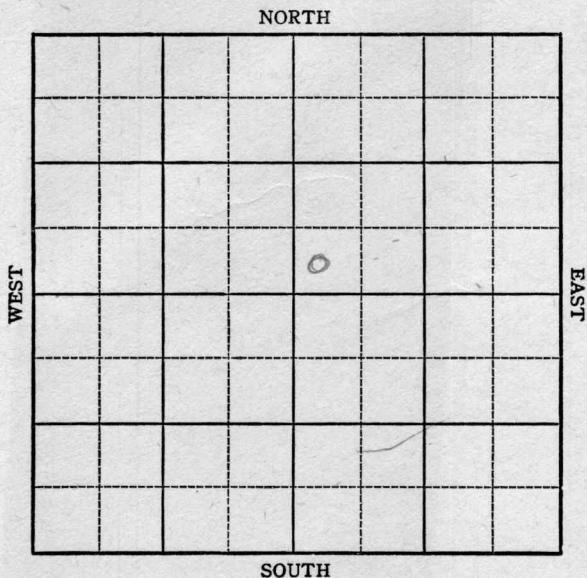

Sec. 21 Twp. 20 R. 35W

Well No. 1 Henry Fee (Strat Test) Farm

Gulf Company


Wildcat

Ft. from N. Line

330 Ft. from S. Line

Ft. from E. Line

330 Ft. from W. Line

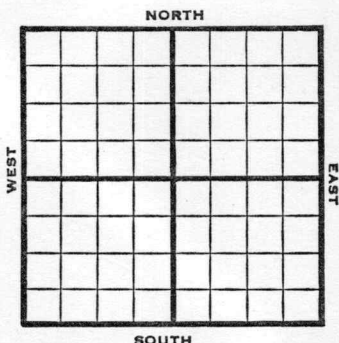

SW NE

1946 Elev. 3176' REPORT

- 12/11 Blaine 1480'
- Herington 2691'
- Krider 2729'
- Winfield 2779'
- Florence 2874'
- Kinney 2764'
- Wreford 3004'
- Cottonwood 3145'
- TD 3165'
- D&A

FIRST REPORT
✓
ABANDONED

Map No. _____ Sec. 21 Twp. 20 R. 35W

Well No. 1 Henry Fee (Strat test)

Gulf

Company

FIRST REPORT

Contractor

SW NE

ABANDONED

E13176

SECTION PLAT

		0	

_____ Ft. from N. Line

330 Ft. from S. Line

_____ Ft. from E. Line

330 Ft. from W. Line

Wichita County

Location _____

Rig up _____

Drilling and Remarks:

Blaine 1480
 Herington 2691
 Krider 2729
 Winfield 2779
 Florence 2874
 Kinney 2764
 Wreford 3004
 Cottonwood 3145
 D & A

RECORD

Cased _____ in., _____ ft.

Sand _____

Gas _____

Oil _____

Total Depth 3165

PRODUCTION

1st 24 hrs. Nat. _____

1st 24 hrs. after shot _____

Gas _____ Cu. Ft.

Dry Hole _____

Abandoned _____

Date

DEC 1 1 1946

19

S. J. LEWIS

Scout