


SECTION 1 TOWNSHIP 21S RANGE 1W

WELL NO. #1 Brandt

COMPANY Lario Oil & Gas

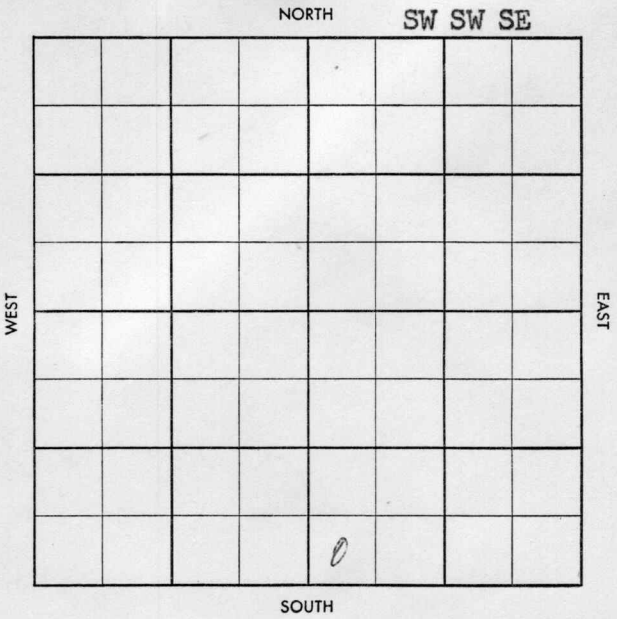

Top  Foot   
Co.  Facet

County McPherson Elev. \_\_\_\_\_  
Sec. 1 Twp. 21 Rge. 1W  
Company Lario Oil & Gas  
Farm Name Brandt No. 1

TOPS	DEPTH	LOG	DATUM
Anh.			
Tp.			
H.			
Tr.			
Dg.			
B.L.			
L.			
K.C.			
B.K.C.			
Ce.			
C.			
M.			
M.			
K.			
Mz.			
Mq.			
V.			
S.			
S.			
A.			
R.			
Pf.			
G.			
T.D.			

Loc. in Sec. \_\_\_\_\_

SW SW SE

Geol. \_\_\_\_\_

Contr. \_\_\_\_\_

Pool \_\_\_\_\_

Goossel



Date Comm. \_\_\_\_\_

Location

Co.  
No.  
Sec.  
T.  
R.

Twp. ~~Pool~~

Co. ~~Facet~~

5-513-B

County McPherson Elev. 1539 RB 15370A  
 Sec. 1 Twp. 21 Rge. 1W  
 Company Lario Oil & Gas  
 Farm Name Brandt No. 1

TOPS	DEPTH	LOG	DATUM
Anh.			
Tp.			
H.			
Tr.			
Dg.			
B.L.	<u>2333</u>		
L.	<u>2342</u>		
K.C.			
B.K.C.			
Ce.			
C.			
M.	<u>2961</u>		
M.			
K.	<u>3261</u>		
Mz. <u>Hunt</u>	<u>3396</u>		
Mq.			
V.			
S.			
S.			
A.			
R.			
Pf.			
G.			
T.D.	<u>3400</u>		

Loc. in Sec. SW SW SE

Geol. \_\_\_\_\_  
Contr. \_\_\_\_\_  
Pool Goessel

**COMPLETE**  
 JUN 25 '58  
 .

Date Comm. 5-16-58 8" 210/100  
 Location MAY 21 '58 1961 MAY 28 '58 Tops  
no tests in logs 5 1/2" 3397/75  
WOC JUN 3 '58 CO 3400 \$15goph  
NW NT 50A \$16goph NW NT  
(4) \$24BONW 4 hrs tests JUN 11 '58  
POP JUN 18 '58 JUN 25 '58 POP 33BOPD  
2570 W N 42°  
HUNTON 3397-3400

Co.  
No.  
Sec.  
T.  
R.