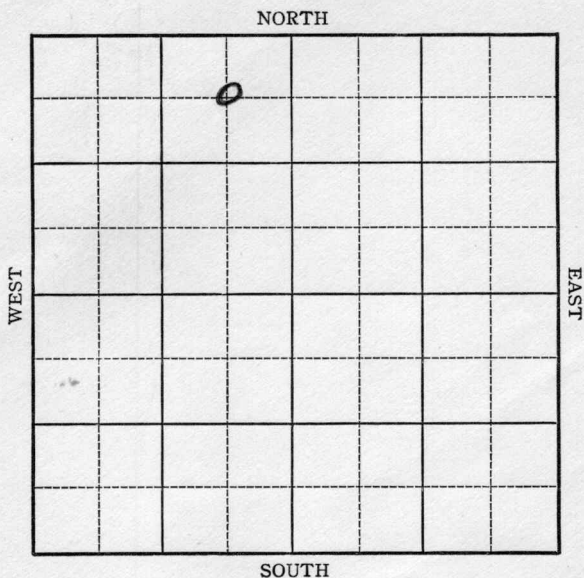



KANSAS

Scott

Section 14 Township 20 Range 33-WWell No. #3 DagueCompany Atlantic Ref.

Sec. 14 Twp. 20 R. 33-WWell No. #3 Dague FarmAtlantic Refg. Company660 Ft. from N. Line Ft. from S. Line660 Ft. from E. Line Ft. from W. Line

Elev. 2937

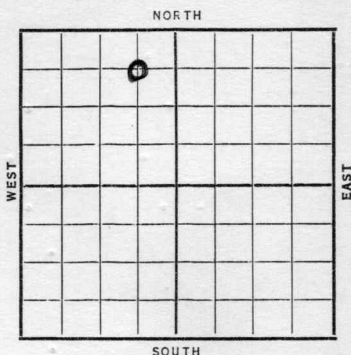

Date

REPORT

O. W. D. D

1937

10/20 Location

10/29 12" @ 251'. Drlg. 1300'.

11/5 Drlg. 3142'.

11/12 Drlg. 4200'.

11/19 Cored 4622-30' T.D.

Sat. in core. Rng. pipe.

11/26 Miss. 4600'. 7" @ 4611'.

T.D. 4630'. RUST.

12/3 T.D. 4642'. Making 20% water.
5000 acid.

12/10 " "

12/17 Pot. 143 oil & 20% water.
S.D.O.

OVER

1937

12/22 7" @ 4611'.

Miss. 4600'.

T.D. 4642'.

5000 acid.

Potential 143 oil.

20% water.

COMPLETED

1938

O. W. D. D.

4/27 Old T.D. 4642'.

Drlg. 4731'.

5/6 Drlg. 4873'.

5/12 T.D. 4911'. S.W.D.

Took 300 bbls. water per hour.

Will acidize.

5/18 T.D. 4911'.

Input: 300 bbls. water per hour
by vacuum.

SALT WATER DISPOSAL:

ABANDONED

1941

O. W. D. D.

1/8 Old T.D. 4642'

Miss. 4600'

Drlg. deeper.

1/16 " "

1/23 Drlg. 4760'

1/30 Drlg. 5030'

OVER

1941
2/6 5030' SD for repairs.
2/13 Viola 5215' Arb. 5375'
Drlg. 5540'
2/20 T.D. 5603' in Arb.
925' of 5" liner cemented at
5373' WOC.
2/26 Arb. 5375'
T.D. 5620'
925' of 5" liner 5373'
7000 acid.
Input 325 bbls. water per hour
on vacuum.
SALT WATER DISPOSAL.

ABANDONED

scott KANSAS

Map No. _____ Sec. 14 Twp. 20 R. 33WWell No. 3 Dague

Atlantic Ref. _____ Company _____

Contractor _____

FIRST REPORT

C NE NW

SECTION PLAT

	0		

660 Ft. from N. Line

_____ Ft. from S. Line

660 Ft. from E. Line

_____ Ft. from W. Line

Location X

Rig up _____

Drilling and Remarks: _____

RECORD

Cased _____ in., _____ ft.

Sand _____

Gas _____

Oil _____

Total Depth _____

PRODUCTION

1st 24 hrs. Nat. _____

1st 24 hrs. after shot _____

Gas _____ Cu. Ft.

Dry Hole _____

Abandoned _____

Date

OCT 20 1937 19

H. D. Hatfield

Scout

Scott

KANSAS

Map No. NM Sec. 14 Twp. 20 R. 33WWell No. 3 DagueAtlantic Refining Company

Contractor

COMPLETED

C NE NW

660 Ft. from N. Line Ft. from S. Line660 Ft. from E. Line Ft. from W. Line

SECTION PLAT

	0		

Location Rig up

Drilling and Remarks:

5000 acidPOT- 143 oil
20 % water

RECORD

Cased 7 in., 4611 ft.Sand MISS 4600Gas Oil Total Depth 4642

PRODUCTION

1st 24 hrs. Nat. 1st 24 hrs. after shot Gas Cu. Ft.Dry Hole Abandoned

Date

DEC 22 1937

19

H. D. Hatfield Scout

Scott

KANSAS

Map No. 11 Sec. 14 Twp. 20 R. 33WWell No. 3 DagueAtlantic Refining

Company

Contractor

FIRST REPORT

C NE NW

660 Ft. from N. Line Ft. from S. Line660 Ft. from E. Line Ft. from W. Line

SECTION PLAT

	0		

Location Rig up

Drilling and Remarks:

OWDD OTD 4642

Drlg. 4731

RECORD

Cased in., ft.Sand Gas Oil Total Depth

PRODUCTION

1st 24 hrs. Nat. 1st 24 hrs. after shot Gas Cu. Ft.Dry Hole Abandoned

Date

APR 27 1938

19

H. D. Hatfield Scout

Scott KANSAS

Map No. NM Sec. 14 Twp. 20 R. 33WWell No. 3 DagueAtlantic Refining Company

Contractor

COMPLETED

C NE NW

660 Ft. from N. Line Ft. from S. Line660 Ft. from E. Line Ft. from W. Line

SECTION PLAT

	0		

Location Rig up

Drilling and Remarks:

*S. W. D.**INPUT - 300**bbls wtr P. H.**by vacuum*

RECORD

Cased in., ft.Sand Gas Oil Total Depth 4911

PRODUCTION

1st 24 hrs. Nat. 1st 24 hrs. after shot Gas Cu. Ft.Dry Hole Abandoned

Date

MAY 18 1938

19

H. D. Hatfield

Scout

Map No. NM Sec. 14 Twp. 20 R. 33WWell No. 3 DagueAtlantic

Company

FIRST REPORT

Contractor

SECTION PLAT

C NE NW

660 Ft. from N. Line Ft. from S. Line660 Ft. from E. Line Ft. from W. Line

SHALLOW WATER POOL

	°		

Location **RECORD**Cased in., ft.Sand Gas Oil Total Depth Rig up

Drilling and Remarks:

OWDD-OTD 4642

Miss. 4600

Drlg. deeper

PRODUCTION1st 24 hrs. Nat. 1st 24 hrs. after shot Gas Cu. Ft.Dry Hole Abandoned

Date

JAN 8 1941

19

S. J. LEWIS Scout

Map No. NM Sec. 14 Twp. 20 R. 33WWell No. 3 DagueAtlantic

Company

~~ABANDONED~~

Contractor

~~ABANDONED~~

SECTION PLAT

C NE NW

	0		

660 Ft. from N. Line

Ft. from S. Line

660 Ft. from E. Line

Ft. from W. Line

SHALLOW WATER POOL

Location _____

RECORD

Cased _____ in., _____ ft.

Sand _____

Gas _____

Oil _____

Total Depth 5620

Rig up _____

Drilling and Remarks:


PRODUCTION

1st 24 hrs. Nat. _____

1st 24 hrs. after shot _____

Gas _____ Cu. Ft.

Dry Hole _____

Abandoned _____

Date

FEB 26 1941

19

S. J. LEWIS

Scout