


Scott

Form 51—5M—5-34—Palace

Map No. **KANSAS** Sec. *15* Twp. *20* R. *33W*

Well No. *1* *Banamen* Farm
Atlantic Oil Company

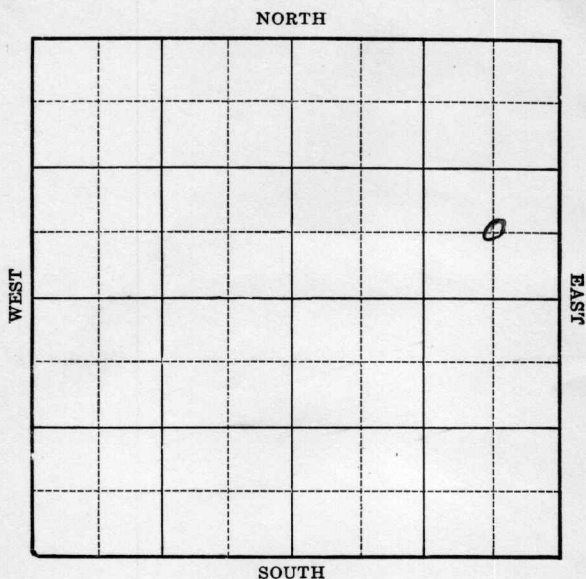

Location _____

Drilling Remarks _____

Rig Up _____

Drilling Remarks _____

RECORD

Cased _____ in. _____ ft.

Sand _____

Gas _____

Oil _____

Total Depth _____

PRODUCTION

1st 24 hrs. Nat. _____

1st 24 hrs. after shot _____

Gas _____ cu. ft. _____

Dry Hole _____

Abandoned _____

Scott

Map No. KANSAS Sec. 15 Twp 20 R. 33W


Well No. 1 Banawan Farm
Atlantic Oil Company

 Ft. from N. Line

660 Ft. from S. Line

660 Ft. from E. Line

 Ft. from W. Line

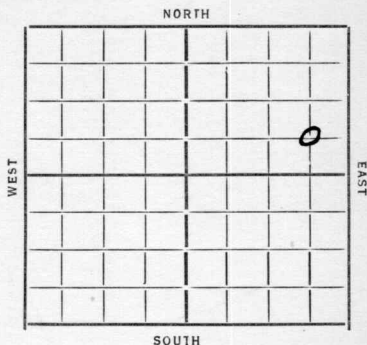

Date 1934

REPORT

7/25	Location
8/2	Cellar
8/9	Rgn Rot.
8/16	12" 243
8/23	dly 1760
8/30	" 2270
9/6	" 2622 Shs gas 2605
9/13	7sq 2628
9/20	dly 2823
9/27	" 3326
10/4	" 3633
10/11	" 4014
10/18	10" 4014 T Lansing 3945 Rust
10/25	_____
11/1	HFW 4130-40 dly 4195
11/8	dly 4334
11/15	8" 4387 C.O.
11/22	7sq 4565
11/28	22 8" 4565
12/9	4670-4680 2700 feet oil hole prod FROM base of Pennsylvania shut down (Telegram)

- OVER -

12/13 Core 4681 - Saturation
26.4 %.

12/21 T 4686 Swab 7 Bbls
per hr.

12/27 —

1/3/35 1000 acid

1/10 P 572 Bbls 24 hrs.

1/17 —

1/24 Will keep

1/31 T 4688 No Inc.

2/7 T 4701 apparently No Inc.

2/14 4722 log core Barrel

2/21 tubing to give pumping
test

2/28 —

3/6 Oil 4690 T 4722
572 Bbls.

COMPLETED

KANSAS

Map No. 76 Map Sec. 15 Twp. 20 R. 33WWell No. 1-BanamanAtlantic Oil Company

Contractor

FIRST REPORTS

SECTION PLAT

			0

_____ Ft. from N. Line

660 Ft. from S. Line660 Ft. from E. Line

_____ Ft. from W. Line

Location ✓

Rig up _____

Drilling and Remarks:

RECORD

Cased _____ in., _____ ft.

Sand _____

Gas _____

Oil _____

Total Depth _____

PRODUCTION

1st 24 hrs. Nat. _____

1st 24 hrs. after shot _____

Gas _____ Cu. Ft.

Dry Hole _____

Abandoned _____

Date

7-25-34 19

ORVAL MANNSCHRECK Scout

Map No. *No Map* Sec. *15* Twp. *20* R. *33W*Well No. *1-Banaman**Atlantic Oil* Company

Contractor

COMPLETED

SECTION PLAT

			0

Ft. from N. Line

660 Ft. from S. Line*660* Ft. from E. Line*10* Ft. from W. Line

Location

Rig up

Drilling and Remarks:

RECORD

Cased in., ft.

Sand

Gas

Oil *4670*Total Depth *4722*

PRODUCTION

1st 24 hrs. Nat.

1st 24 hrs. after shot

Gas Cu. Ft.

Dry Hole

Abandoned

Date

ORVAL MANSCHRECK

3-6-35 192

Scout