


Section 1 Township 20 Range 34-W

Well No. #1 Lang

Company Texas
Wildcat

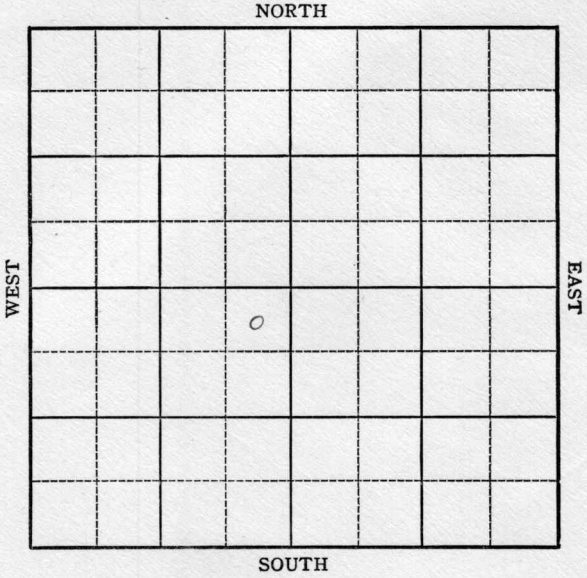

Scott

KANSAS

Sec. 1 Twp. 20 R. 34W ✓

Well No. #1 Lang Farm

Texas

Company

Wildcat Contractor


330' Ft. from N. Line

Ft. from S. Line

330' Ft. from E. Line

Ft. from W. Line

NE SW

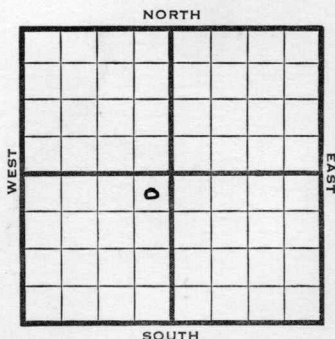

1949 Elev. 3010' REPORT

11/9 RUR

11/16 10" @ 340'

Drlg 2900'

11/23 Ft Riley 2860'

Lansing 3912'

Drlg 3975'

11/29 BKC 4318'

Drlg 4570'

12/7 Miss 4756'

Drlg 5009'

12/14 TD 5105'

7" @ 4600'

12/28 Miss 4756'

TD 5105'

ABANDONED

Map No. _____ Sec. 1 Twp. 20 R. 34W

Well No. 1 Lang

Texas

Company

Contractor

NE SW


FIRST REPORT
SECTION PLAT

330 Ft. from N. Line

_____ Ft. from S. Line

330 Ft. from E. Line

_____ Ft. from W. Line

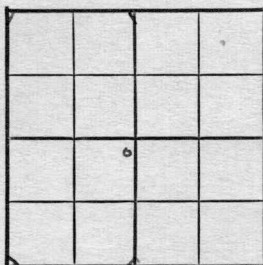

Scott County

Location _____

Rig up _____

Drilling and Remarks:

R U R

RECORD

Cased _____ in., _____ ft.

Sand _____

Gas _____

Oil _____

Total Depth _____

PRODUCTION

1st 24 hrs. Nat. _____

1st 24 hrs. after shot _____

Gas _____ Cu. Ft.

Dry Hole _____

Abandoned _____

Date

NOV 9 1949

19

S. J. LEWIS

Scout

Kansas

Wildcat

Map No. _____ Sec. 1 Twp. 20 R. 34WWell No. 1 Lang


Texas

Company _____

ABANDONED

Contractor _____

NE SW

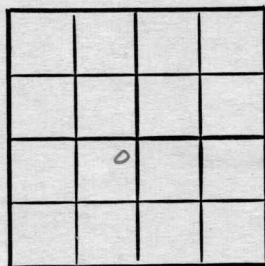E 13018
SECTION PLAT330 Ft. from N. Line

_____ Ft. from S. Line

330 Ft. from E. Line

_____ Ft. from W. Line

Scott County

Location _____

Rig up _____

Drilling and Remarks:

Wier 4256

RECORD

Cased _____ in., _____ ft.

Sand _____

Gas _____

Oil _____

Total Depth 5105

PRODUCTION

1st 24 hrs. Nat. _____

1st 24 hrs. after shot _____

Gas _____ Cu. Ft.

Dry Hole _____

Abandoned _____

Date

DEC 28 1949

19

S. J. LEWIS

Scout