

Section 6 Township 20 Range 36W

Well No. #1 O.W. Lehner

Company J.S. Woodward

NORTH

|  |  |  |  |  |  |  |   |
|--|--|--|--|--|--|--|---|
|  |  |  |  |  |  |  |   |
|  |  |  |  |  |  |  |   |
|  |  |  |  |  |  |  |   |
|  |  |  |  |  |  |  | 0 |
|  |  |  |  |  |  |  |   |
|  |  |  |  |  |  |  |   |
|  |  |  |  |  |  |  |   |
|  |  |  |  |  |  |  |   |

WEST

EAST

SOUTH

Wichita

KANSAS

|      |   |      |    |    |     |
|------|---|------|----|----|-----|
| SEC. | 6 | TWP. | 20 | R. | 36W |
|------|---|------|----|----|-----|

WELL NO.

#1 O.W. Lehner

FARM

COMPANY

J.S. Woodward

CONTRACTOR


Mid-Western  
Wildcat.

\_\_\_\_\_ Ft. from N. Line

330 \_\_\_\_\_ Ft. from S. Line

330 \_\_\_\_\_ Ft. from E. Line

\_\_\_\_\_ Ft. from W. Line

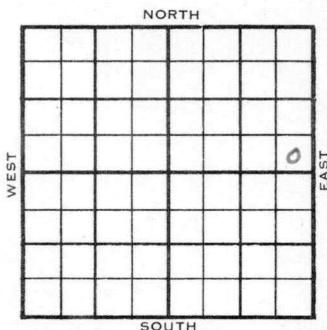


SE SE NE

Amerada - acreage Sinclair \$3500

|       | ELEVATION   | REPORT    |
|-------|---|-----------|
| 1953  | 3277'   | Miss Test |
| 9/23  | Spud 9-15-53<br>10" @ 357'<br>Drlg 1316'   |           |
| 9/30  | Greenhorn 610' Dakota 720'<br>Morrison 1090' Blaine 1525'<br>Stone C. 2230' Hugoton Zo 2710'<br>Wab. 3632' Top 3725'<br>Fish @ 3775'   |           |
| 10/7  | DST 4116'-54' 1 hr, 1830' Sulph wtr<br>1065#<br>Drlg 4318'   |           |
| 10/14 | Spud 9-15-53 D & A TD 5055'<br>10" @ 357 Greenhorn 610' Dakota 720'<br>Morrison 1090' Blaine 1525'<br>Stone corral 2230' Hugoton 2710'<br>Waubaussee 3632' Top 3725'<br>DST 4115-54 open 1 hr rec 1830' sul.<br>wtr. 1065# Heeb 4020' Lans 4060'<br>Miss. 49448' TD 5055' D & A |           |

ABANDONED

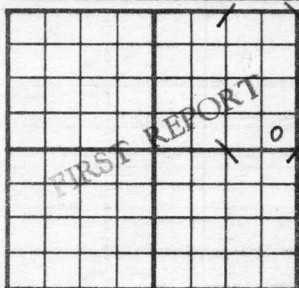
County Wichita State KansasSec. 6 (Blk.) 20 (Sur.) 36W Map No.Operator J. S. WoodwardWell No. 1 Farm O. W. LehnerElev. Location SE SE NE330 Ft. From S Line NE330 Ft. From E Line Quarter1st. Report SEP 23 1953

Completion

Remarks Amerada - acreage  
Sinclair - \$3500Mid-Western - Contr.Spudding Date 9-15-53Drlg. Data Miss. test Wildcat10" @ 357 drlg. 1316

J. G. McGEHEE

County Wichita State Kansas  
 Sec. 6 (Blk.) 20 (Sur.) 36W Map No.  
 (Twp.)  
 Operator J. S. Woodward  
 Well No. 1 Farm O. W. Lehner  
 Elev. 3277 Location SE SE NE

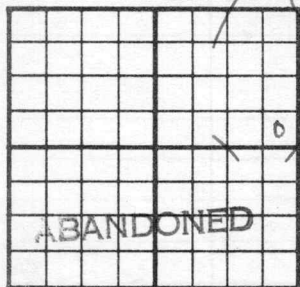

330 Ft. From S Line NE

330 Ft. From E Line Quarter

1st. Report

Completion OCT 14 1953

Remarks Wildcat

Mid-Western - Contr.

Spudding Date 9-15-53

Drlg. Data D & A TD 5055

10" @ 357 Greenhorn 610 Dakota 720

Morrison 1090 Blaine 1525 Stone corral

2230 Hugoton 2710 Waubaunsee 3632

Top. 3725 DST 4115-54 open 1 hr.

Rec. 1830' sul. wtr. 1065# Heeb. 4020

Lans. 4060 Miss. 4944 TD 5055

D & A

J. G. McGEHEE