


SECTION 5 TOWNSHIP 21 RANGE ~~##~~ 1W

WELL NO. #1 Wilkering

COMPANY Cherry Drlg.

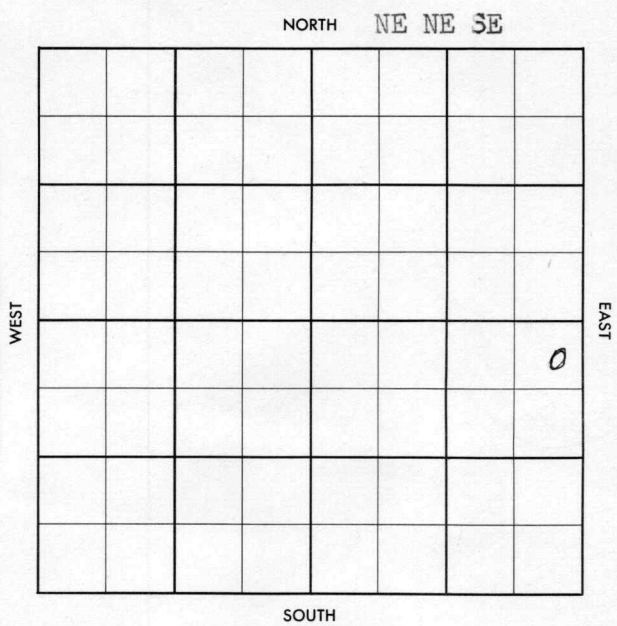

WILDCAT

FORM 513 SUNRAY

County McPherson Elev. _____
 Sec. 5 Twp. 21 Rgs. 1W
 Company Cherry Drlg.
 Farm Name Wilkering No. 1

TOPS	DEPTH	LOG	DATUM
Anh.			
Tp.			
H.			
Tr.			
Dg.			
Bl.			
L.			
K.C.			
B.K.C.			
Ce.			
C.			
M.			
M.			
K.			
Mz.			
Me.			
V.			
S.			
S.			
A.			
R.			
Pe.			
G.			
T.D.			

Loc. in Sec. NE NE SE

Geol. _____

Contr. _____

Co. tools

Pool _____

Wildcat

FIRST REPORT

MAY 1 57

Date Comm. 4-29-57

8" @ 200 WOC

Co.

Lse.

No.

Sec.

T.

R.

County McPherson Elev. 1507
 Sec. 5 Twp. 21 Rge. 1W
 Company Cherry Drlg.
 FarmName Wilkering No. 1

TOPS	DEPTH	LOG	DATUM	Loc. in Sec.
Anh.				NE NE SE
TP.				
H.				
Tr.				
Dg.				
Bl.				
L.	2345			Geol.
K.C.				Contr.
B.K.C.				
Ce.				Co. tools
C.				
M.	2936			Pool
M.				Wildcat
K.	3239			
Mz.				
Ma.				
V.	3433			ABANDONED 0 MAY 22 57
S.	3467			
S.				
A.	3536			
R.				
Pe.				
G.				
T.D.	3574			

Date Comm. 4-29-57 Tex DH AC. Patch
8" @ 200 WOC MAY 9 57 D 2510 MAY 15 57

DST 2970-80 lhr 5' Md
BHP 135 DST 3002-21
lhr 2 1/3" sec 105' HOCM
+ 30' SOC M + 30' OCSW + 240'
SW FPC-235 BHP 865/15
DST 3460-70 lhr 62' MSW BHP
875/20 MAY 22 57

D&A.