


Map No. KANSAS Sec. 9 Twp. 21 R. 1 W
Well No. 1-Willkennig Farm
Marland Oil & Gas Company

NORTH

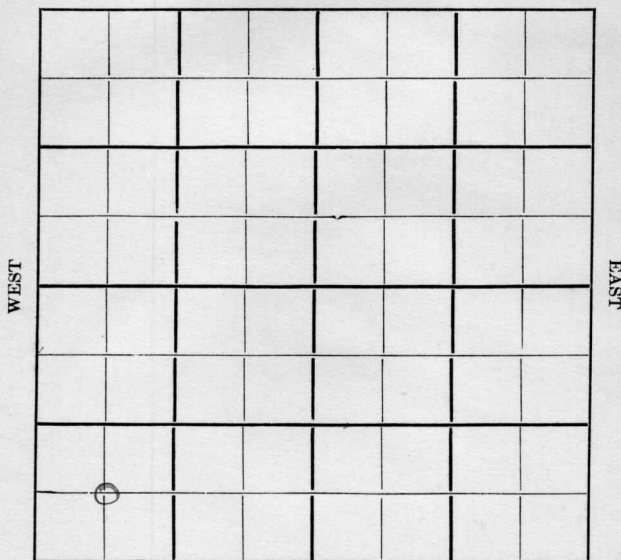

SOUTH

Location.....

Drilling Remarks

.....

.....

RECORD

Cased.....in.....ft.

Sand.....

Gas.....

Oil.....

Total Depth.....

Rig Up.....

Drilling Remarks

.....

.....

PRODUCTION

1st 24 hrs. Nat.....

1st 24 hrs. after shot.....

Gas.....cu. ft.....

Dry Hole.....

Abandoned.....


Map No. **KANSAS** Sec. 9 Twp. 21 R. 1^w
Well No. 1- Wilkenning Farm
Marland Oil Company

.....Ft. from N. Line

660 Ft. from S. Line

.....Ft. from E. Line

660 Ft. from W. Line

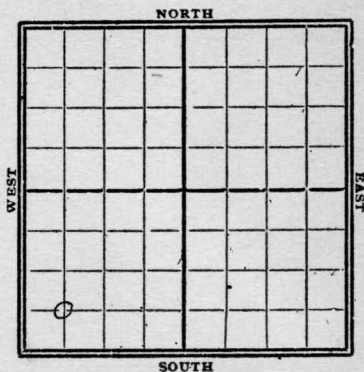

1928

Date

REPORT

11/14	Location
11/21	
11/28	
12/15	Bldg Rig
12/12	Rig up
12/19	Spud 350'
12/26	drlg 650'
1929	
1/2	" 705'
1/9	" 830'
1/16	" 1365'
1/23	" 1600'
1/30	" 1890'
2/6	" 2050'
2/13	" 2180'
2/20	" 2285'
2/27	S.D. 2285' = T.D.
3/6	drlg 2650'
3/13	UIR 8" cs 2765'
3/18	Top Chat 2908'
	show water
	show gas 2938'

3/20 - Top chat 2908'
1/2 44 gas 2975'
show oil 2910
HFW 2970 - 3000'
dry 3002'

3/27 - U.R. 6" - 3010' T.D.

4/3 - Dry 3110'

4/10 - " 3174'

4/17 - Viola lime 3408 small
show oil - oil 3440-45
hole full water
shut down

4/24 - Dry 3475'

5/1 - U.R. 5" - 3530'

5/8 -

5/15 T.D. 3564'

Dry & Abandoned

MAP No. KANSAS SEC. 9 TWP. 21 R. 1W

WELL No. 1 Wilkenning

Marland Oil COMPANY

CONTRACTOR

SECTION PLAT

0			

_____ FT. FROM N. LINE

660 FT. FROM S. LINE

_____ FT. FROM E. LINE

660 FT. FROM W. LINE

FIRST REPORTS

LOCATION ✓

RIG UP _____

DRILLING AND REMARKS:

RECORD

CASED _____ IN. _____ FT.

SAND _____

GAS _____

OIL _____

TOTAL DEPTH _____

PRODUCTION

1ST 24 HRS. NAT. _____

1ST 24 HRS. AFTER SHOT _____

GAS _____ CU. FT.

DRY HOLE _____

ABANDONED _____

DATE

NOV 14 1928

192

S. J. LEWIS SCOUT

Map No. KANSAS Sec. 9 Twp. 21 R. 1W

Well No. 1 Hilkenning

Harland Oil Company

Contractor

SECTION PLAT

.....Ft. from N. Line

660 Ft. from S. Line

.....Ft. from E. Line

660 Ft. from W. Line

ABANDONED

Location.....

Rig up.....

Drilling and Remarks:

DAH

RECORD

Cased.....in.,ft.

Sand.....

Gas.....

Oil.....

Total Depth 8564

PRODUCTION

1st 24 hrs. Nat.....

1st 24 hrs. after shot.....

Gas.....Cu. Ft.

Dry Hole.....

Abandoned.....

Date

MAY 15 1929

192.....

S. J. LEWIS Scout