


Section 17 Township 21 Range 1-W

Well Number #4 Goering

Company Dickey & Gulf

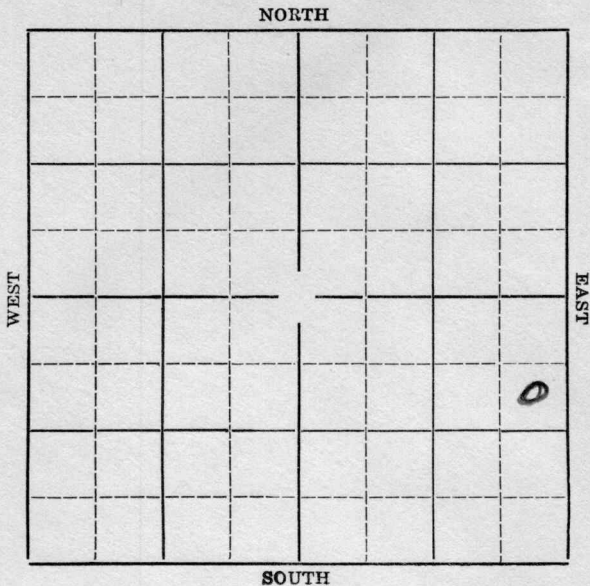


KANSAS

McPherson

Sec. 17 Twp. 21 R. 1-WWell No. 4 Goering FarmDickey & Gulf Company990 Ft. from N. Line Ft. from S. Line330 Ft. from E. Line Ft. from W. Line

Elev. 1478

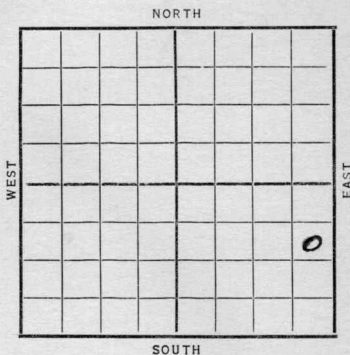~~1936~~

REPORT

11/4 R. O. G.

11/12 Rig

11/19 10" @ 165'. Drlg.

11/27 Drlg. 2300'.

12/3 Chat 2910'. Drlg. 3145'.

12/9 ~~Hunton~~ ~~3250~~~~4000 acid~~ Pot. 948~~T.D. 3273~~~~COMPLETED~~

12/16 Hunton 3307'. 4000 acid.

T. D. 3340'.

Pot. 2429.

COMPLETED

Map No. 43 Sec. 17 Twp. 21 R. 1W

Well No. 4 Goering

Dickey & Gulf. Company

Contractor

SECTION PLAT

990 Ft. from N. Line

_____ Ft. from S. Line

880 Ft. from E. Line

_____ Ft. from W. Line

			0

FIRST REPORT

Location _____

Rig up _____

Drilling and Remarks:

ROG

RECORD

Cased _____ in., _____ ft.

Sand _____

Gas _____

Oil _____

Total Depth _____

PRODUCTION

1st 24 hrs. Nat. _____

1st 24 hrs. after shot _____

Gas _____ Cu. Ft.

Dry Hole _____

Abandoned _____

Date

NOV 4 1936 19

S. J. LEWIS

Scout

KANSAS

Map No. 43 Sec. 17 Twp. 21 R. 1W.Well No. 4 GoringHickory & Gulf. Company

Contractor

SECTION PLAT

			0

990 Ft. from N. Line

_____ Ft. from S. Line

330 Ft. from E. Line

_____ Ft. from W. Line

COMPLETED

Location _____

Rig up _____

Drilling and Remarks:

Hutton 33874000 acidPer 2429

RECORD

Cased _____ in., _____ ft.

Sand _____

Gas _____

Oil _____

Total Depth 3340

PRODUCTION

1st 24 hrs. Nat. _____

1st 24 hrs. after shot _____

Gas _____ Cu. Ft.

Dry Hole _____

Abandoned _____

Date

DEC 16 1936

19

S. J. LEWIS Scout