


Company, Dickey Oil et al

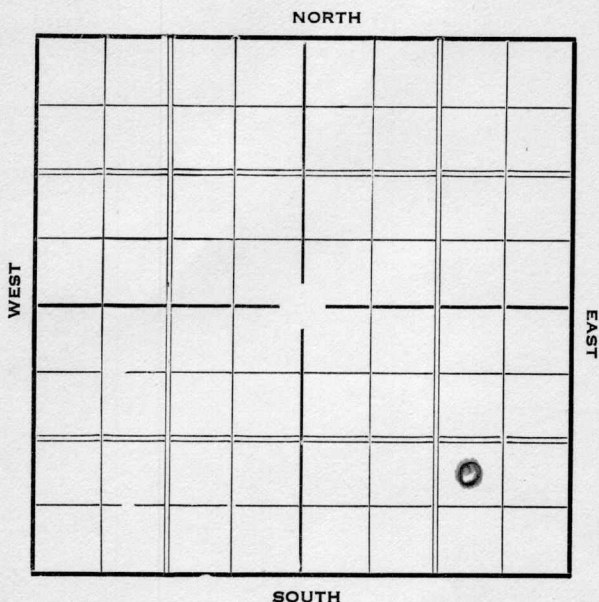


KANSAS

McPherson

Map No. _____ Sec. 17 Twp. 21 R. 1-W

Well No. #6 Goering Farm

Dickey Oil et al Company

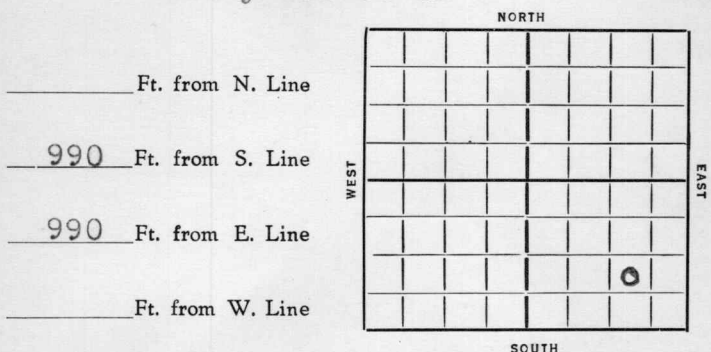

Date
1936

REPORT

12/16	Location
-------	----------

12/24 "

12/29 Rig.

1937

1/7 10" @ 156'. WOC.

1/14 Drlg. 2200'.

1/21 Chat 2918'. Drlg. 3183'.

1/28	Hunton 3318' set 6".
------	----------------------

T. D. 3348'. 1500' oil.

2/3 Hunton 3317'.

T. D. 3348'.

4000 acid.

Potential 1886..

COMPLETED

Map No. 43 Sec. 17 Twp. 21 R. 14

Well No. 6 Goering

Dickey Oil & Gas Co. Company

Contractor

SECTION PLAT

 Ft. from N. Line

990 Ft. from S. Line

990 Ft. from E. Line

 Ft. from W. Line

FIRST REPORT

Location ✓

Rig up

Drilling and Remarks:

RECORD

Cased in., ft.

Sand

Gas

Oil

Total Depth

PRODUCTION

1st 24 hrs. Nat.

1st 24 hrs. after shot

Gas Cu. Ft.

Dry Hole

Abandoned

Date

DEC 16 1936

19

S. J. LEWIS

Scout

KANSAS

Map No. 43 Sec. 17 Twp. 21 R. 1WWell No. 6 GoeringDickey Oil Company

Contractor

SECTION PLAT

			0

_____ Ft. from N. Line

990 Ft. from S. Line990 Ft. from E. Line

_____ Ft. from W. Line

COMPLETED

RECORD

Location _____

Cased _____ in., _____ ft.

Rig up _____

Sand _____

Drilling and Remarks:

Gas _____

Oil _____

Total Depth 3348

PRODUCTION

1st 24 hrs. Nat. _____

1st 24 hrs. after shot _____

Gas _____ Cu. Ft.

Dry Hole _____

Abandoned _____

Date

FEB 3 1937 19

S. J. LEWIS

Scout

Hunter 3317
4000 acid
Potential
1886.