


Section 19 Township 21 Range 1-W

Well No. 1 H. Meyer

Company Continental

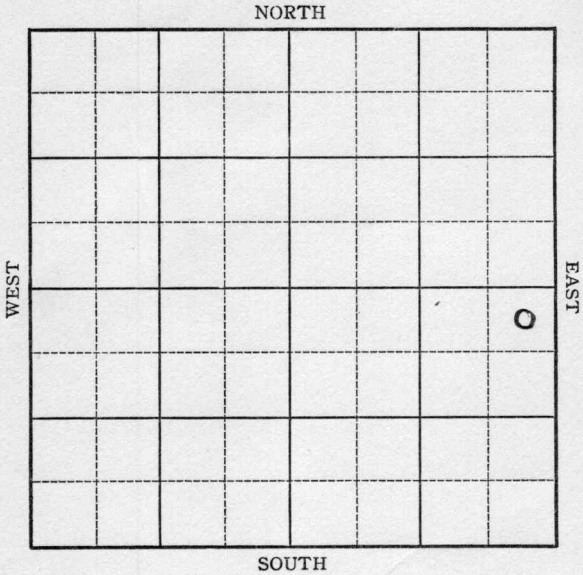

Sec. 19 Twp. 21 R. 1-WWell No. #1 H. Meyer Farm
Continental Company330

Ft. from N. Line


Ft. from S. Line

330

Ft. from E. Line

Ft. from W. Line

NORTH

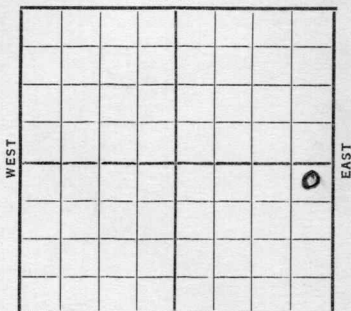

Elev. 1486'.

SOUTH

Date

REPORT

1938

1/12

Cellar.

1/20

10" - 147

Drlg. 630'

1/28

Drlg. 2650'.

2/4

Chat 2946'

Hunton 3336'

Cored 3340-75' oil stains 3343-44 &

3355-61' Drlg. 3400'.

1938

2/9

Viola 3447'.

Simp. Dolo. 3472'.

Simp. sand 3481'.

T.D. 3490' S.W. ?

ABANDONED

McPherson

KANSAS

Map No. 43 Sec. 19 Twp. 21 R. 1WWell No. 1 H. MeyerContinental Company

Contractor

FIRST REPORT

NE SE

330 Ft. from N. Line Ft. from S. Line330 Ft. from E. Line Ft. from W. Line

SECTION PLAT

			0

Location Rig up

Drilling and Remarks:

Cellar

RECORD

Cased in., ft.Sand Gas Oil Total Depth

PRODUCTION

1st 24 hrs. Nat. 1st 24 hrs. after shot Gas Cu. Ft.Dry Hole Abandoned

Date

JAN 12 1938 19H. D. Hatfield Scout

McPherson KANSAS

Map No. 43 Sec. 19 Twp. 21 R. 1WWell No. 1 H. MeyerContinental Company

Contractor

ABANDONED

NE SE

330 Ft. from N. Line Ft. from S. Line330 Ft. from E. Line Ft. from W. Line

SECTION PLAT

			0

Location Rig up

Drilling and Remarks:

Viola 3447
Simp dolo. 3472
Simp sand 3481
TD 3490 s.w.?

D & A

RECORD

Cased in., ft.Sand Gas Oil Total Depth

PRODUCTION

1st 24 hrs. Nat. 1st 24 hrs. after shot Gas Cu. Ft.Dry Hole Abandoned

Date

FEB 9 1938

19

H. D. Hatfield Scout