

KANSAS

McPherson


Section 20 Township 21 Range 1WWell No. 2 HetzkeCompany Shawver-Graham

Graber

NORTH

WEST

EAST

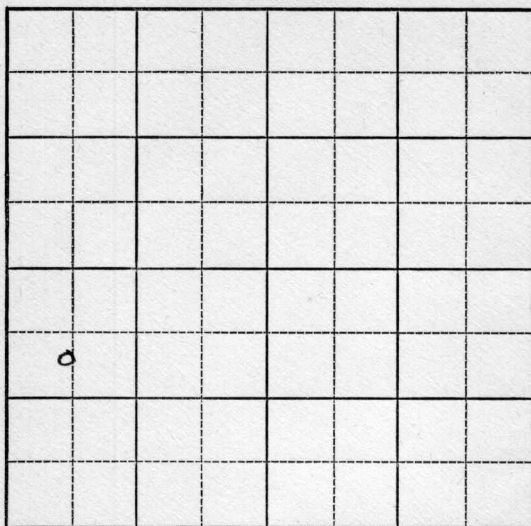

SOUTH

KANSAS

McPherson

Sec. 20 Twp. 21 R. 1W ☒

Well No. #2 Hetzke Farm

Shawver - Graham Company
(Shawver-Graham, Cont.) NORTH


825' Ft. from N. Line

 Ft. from S. Line

 Ft. from E. Line

652' Ft. from W. Line

C S L NW SW

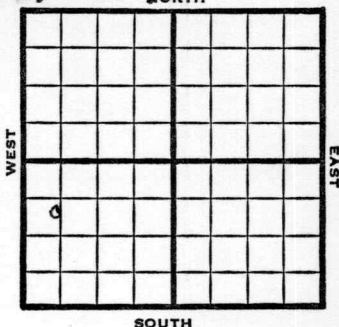

1949

Elev 1490' REPORT

6/1 8" @ 153'
Drlg. 720'

6/7 KC 2332'
Drlg 2750'

6/15 Miss 2942'
Hunton 3280'
TD 3285'
4" @ 3282'

6/21 TD 3311'
Acid 500'

6/29 TD 3311'
Hunton 3280'
4"@ 3282'
5000 acid
Pump 70 Oil Pot
36° Gr.
Comp

COMPLETED

Kansas

Grabber Pool

Map No. _____ Sec. 20 Twp. 21 R. 1WWell No. 2 Hetzke

Shawver - Graham Company

Shawver - Graham Contractor

C S L NW SW

FIRST REPORT
SECTION PLAT825 Ft. from N. Line Ft. from S. Line Ft. from E. Line652 Ft. from W. Line

McPherson County

Location _____

Rig up _____

Drilling and Remarks:

8" @ 153

drlg. 720

RECORD

Cased _____ in., _____ ft.

Sand _____

Gas _____

Oil _____

Total Depth _____

PRODUCTION

1st 24 hrs. Nat. _____

1st 24 hrs. after shot _____

Gas _____ Cu. Ft.

Dry Hole _____

Abandoned _____

Date

JUN 1 1949 19

S. J. LEWIS Scout

Kansas

Graber Pool

Map No. K43 Sec. 20 Twp. 21 R. 1WWell No. 2 Hetzke


Shawver - Graham

Company

COMPLETE

Contractor

C S L NW SW

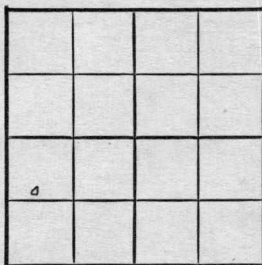E11490
SECTION PLAT825 Ft. from N. Line Ft. from S. Line Ft. from E. Line652 Ft. from W. Line

McPherson County

Location Rig up

Drilling and Remarks:

Hunt on 32504" @ 3252.5000 aadProd 70 oil Bt.36°/hr

RECORD

Cased in., ft.Sand Gas Oil Total Depth 3311

PRODUCTION

1st 24 hrs. Nat. 1st 24 hrs. after shot Gas Cu. Ft.Dry Hole Abandoned

Date

JUN 29 1949

19

S. J. LEWIS

Scout