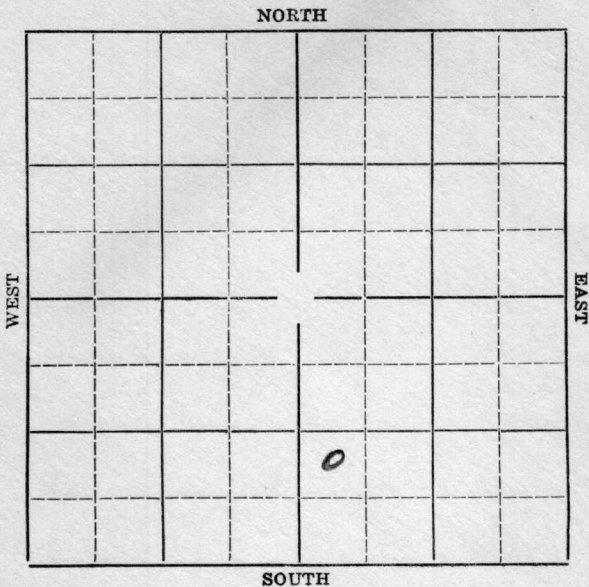


Section 20 Township 21 Range 1-WWell Number #3 HetzkeCompany Continental

KANSAS

Map No. 43 Sec. 20 Twp. 21 R. 1WWell No. 3 HetypeContinental Company

Contractor

SECTION PLAT

		0	

 Ft. from N. Line990 Ft. from S. Line Ft. from E. Line380 Ft. from W. Line

FIRST REPORT

Location Rig up

Drilling and Remarks:

Rig

RECORD

Cased in., ft.Sand Gas Oil Total Depth

PRODUCTION

1st 24 hrs. Nat. 1st 24 hrs. after shot Gas Cu. Ft.Dry Hole Abandoned

Date

OCT 28 1936

19

S. J. LEWIS

Scout

KANSAS

Map No. 43 Sec. 20 Twp. 21 R. 1WWell No. 3 H & T K EContinental Company

Contractor

SECTION PLAT

		o	

 Ft. from N. Line990 Ft. from S. Line Ft. from E. Line330 Ft. from W. Line

COMPLETED

Location Rig up

Drilling and Remarks:

Hunter 32914000 acidPa 8/158

RECORD

Cased in., ft.Sand Gas Oil Total Depth 3229

PRODUCTION

1st 24 hrs. Nat. 1st 24 hrs. after shot Gas Cu. Ft.Dry Hole Abandoned

Date

DEC 22 1936

19

S. J. LEWIS

Scout