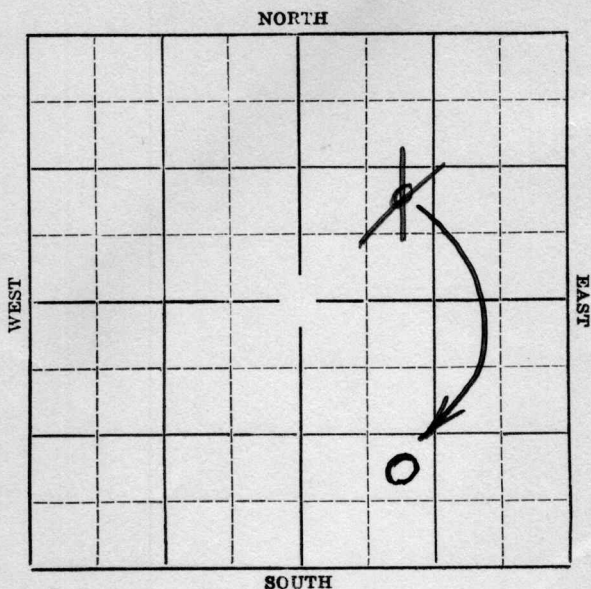


Section 20
29 Township 21 Range 1-WWell Number #2-HetzkeCompany Continental

McPherson

Map No. KANSAS Sec. 20 Twp. 21 R. 1W


Well No. #2 Hetzke Farm
Continental Company

 Ft. from N. Line

990' Ft. from S. Line

 Ft. from E. Line

990' Ft. from W. Line

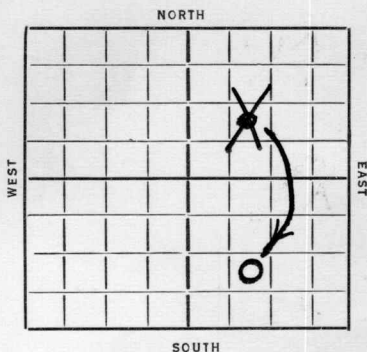

Date
1936

REPORT

6/24 Location

7/2 Rig.

7/9 Drlg. 1650'.

7/16 Chat 2909'. Drlg. 2930'.

7/23 Hunton 3298'. 3000 RUST.

7/30--8/6--

8/5/36-Hunton 3298'.

T.D. 3326'.

4000 gallons of acid.

Pot. 1875 bbls of oil.

COMPLETED

KANSAS

Map No. 43 Sec. 29 Twp. 21 R. 1WWell No. 2 HetzkeContinental Company

Contractor

SECTION PLAT

		0	

 Ft. from N. Line990 Ft. from S. Line Ft. from E. Line990 Ft. from W. Line

FIRST REPORT

Location ✓Rig up Drilling and Remarks:

RECORD

Cased in., ft.Sand Gas Oil Total Depth

PRODUCTION

1st 24 hrs. Nat. 1st 24 hrs. after shot Gas Cu. Ft.Dry Hole Abandoned

Date

JUN 24 1936

19

S. J. LEWIS Scout

#1 in SE SW SE

[Handwritten signature]

Check location we show number one
in SE SW SE

advise
Sam

should have been 29-21-1W
instead of sec. 20.

Returned	<i>[Signature]</i>
Cards	<i>[Signature]</i>
Tracing	<i>[Signature]</i>
France Map	<i>[Signature]</i>
Scarborough Map	<i>[Signature]</i>
Moody Map	<i>[Signature]</i>
Scarborough Plat Book	
Moody Plat Book	

KANSAS

Map No. 43 Sec. 20 Twp. 21 R. 11Well No. 2 H & T CoContinental Company

Contractor

SECTION PLAT

_____ Ft. from N. Line

990 Ft. from S. Line

_____ Ft. from E. Line

990 Ft. from W. Line

CORRECTION

Location _____

RECORD

Cased _____ in., _____ ft.

Sand _____

Gas _____

Oil _____

Total Depth _____

PRODUCTION

1st 24 hrs. Nat. _____

1st 24 hrs. after shot _____

Gas _____ Cu. Ft.

Dry Hole _____

Abandoned _____

Drilling and Remarks:

ReportedNE SW NECorrect Section from29 to 20,

Date

8/5/36 19J. L. Lewis Scout

KANSAS

Map No. _____ Sec. 20 Twp. 21 R. 1WWell No. 2 N & T k rContinental Company

Contractor _____

SECTION PLAT

		0	

_____ Ft. from N. Line

990 Ft. from S. Line

_____ Ft. from E. Line

990 Ft. from W. Line

COMPLETED

Location _____

Rig up _____

Drilling and Remarks:

Hutton 32984000 acidP 8/1875

RECORD

Cased _____ in., _____ ft.

Sand _____

Gas _____

Oil _____

Total Depth 3326

PRODUCTION

1st 24 hrs. Nat. _____

1st 24 hrs. after shot _____

Gas _____ Cu. Ft.

Dry Hole _____

Abandoned _____

Date

8/5/86 19B. Lewis Scout

Person
 Map No. 43 Sec. 20 Twp. 21 R. 1W

Well No. 2 Hctgke

Continental Company

Duplicate Contractor

SECTION PLAT



_____ Ft. from N. Line

990 Ft. from S. Line

_____ Ft. from E. Line

990 Ft. from W. Line

CORRECTION

Location _____

Rig up _____

Drilling and Remarks:

*Reported in
29-21-1W*

*Reported in
NE 34-NE*

RECORD

Cased _____ in., _____ ft.

Sand _____

Gas _____

Oil _____

Total Depth _____

PRODUCTION

1st 24 hrs. Nat. _____

1st 24 hrs. after shot _____

Gas _____ Cu. Ft.

Dry Hole _____

Abandoned _____

Date

AUG 19 1936

19

S. J. LEWIS

Scout

Map No. _____ Sec. 20 Twp. 21 R. 1W

Well No. 2 Hitzke

Continental Company

Duplicate Contractor

SECTION PLAT

		0	

_____ Ft. from N. Line

990 Ft. from S. Line

_____ Ft. from E. Line

990 Ft. from W. Line

COMPLETED

Location _____

Rig up _____

Drilling and Remarks:

Hutton 3298.

4000 acid

PO 1875

RECORD

Cased _____ in., _____ ft.

Sand _____

Gas _____

Oil _____

Total Depth 3326

PRODUCTION

1st 24 hrs. Nat. _____

1st 24 hrs. after shot _____

Gas _____ Cu. Ft.

Dry Hole _____

Abandoned _____

Date

AUG 19 1936

S. J. LEWIS Scout