


Section 20 Township 21 Range 1W

Well Number #1"A" Hetzke

Company Continental et al

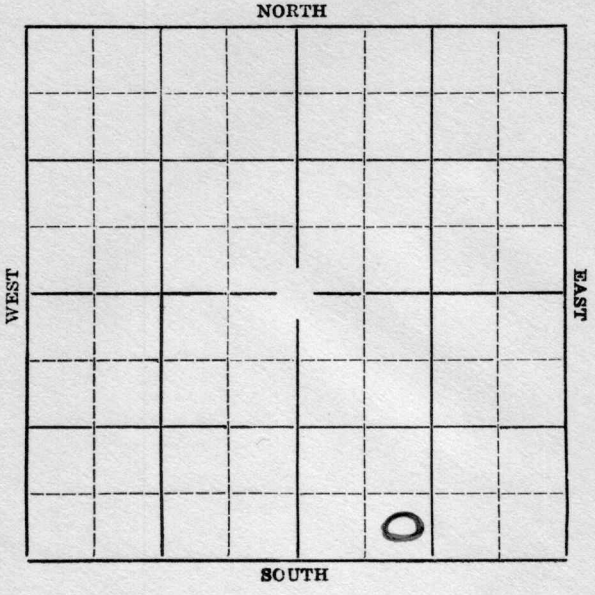

Map No. KANSAS Sec. 20 Twp. 21 R. 1W

Well No. #1 "A" Hetzke Farm


Continental et al Company

\_\_\_\_\_ Ft. from N. Line

330' Ft. from S. Line

\_\_\_\_\_ Ft. from E. Line

990' Ft. from W. Line

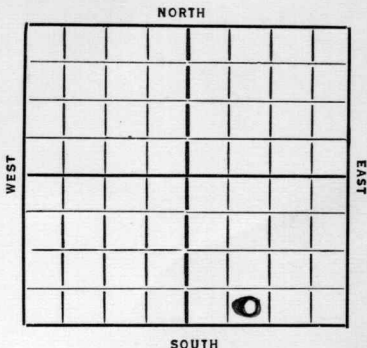

Date 1936

REPORT

5/27 Location

6/4 12" @ 142'. T.D. 148'. W.O.C.

6/11 Drlg. 1778'.

6/18 Drlg. 2520'. ~~Drlg. 2925'.~~

6/25 Chat 2892'. Drlg. 3103'.

7/2 Hunton 3280'. Set 7" @ 3282'. W.O.C.

7/9 Drlg. 3310'. H.F.O.

7/15/36-Chat 2892'.

Hunton 3280'.

Hole full of oil 3310'.

T.D. 3310&.

1645 bbls of oil potential.

**COMPLETED**

*M. Pherson*

Map No. 43 Sec. 20 Twp. 21 R. 14


Continental & Tab Company

Contractor

SECTION PLAT

|  |  |  |  |
|--|--|--|--|
|  |  |  |  |
|  |  |  |  |
|  |  |  |  |
|  |  |  |  |

\_\_\_\_\_ Ft. from N. Line

330 Ft. from S. Line

\_\_\_\_\_ Ft. from E. Line

990 Ft. from W. Line

FIRST REPORT

Location ✓

Rig up \_\_\_\_\_

Drilling and Remarks:

RECORD

Cased \_\_\_\_\_ in., \_\_\_\_\_ ft.

Sand \_\_\_\_\_

Gas \_\_\_\_\_

Oil \_\_\_\_\_

Total Depth \_\_\_\_\_

PRODUCTION

1st 24 hrs. Nat. \_\_\_\_\_

1st 24 hrs. after shot \_\_\_\_\_

Gas \_\_\_\_\_ Cu. Ft.

Dry Hole \_\_\_\_\_

Abandoned \_\_\_\_\_

Date

MAY 27 1936

19

S. J. LEWIS

Scout

Map No. 43 Sec. 20 Twp. 21 R. 1W

Well No. 1 "A" Hetches

Continental Company

Contractor

**SECTION PLAT**

|  |  |  |  |
|--|--|--|--|
|  |  |  |  |
|  |  |  |  |
|  |  |  |  |
|  |  |  |  |

\_\_\_\_\_ Ft. from N. Line

330 Ft. from S. Line

\_\_\_\_\_ Ft. from E. Line

990 Ft. from W. Line

**COMPLETE**

Location \_\_\_\_\_

Rig up \_\_\_\_\_

Drilling and Remarks:

Ohart 2892  
Nanton 3280  
AFD 3310  
POY 1645

**RECORD**

Cased \_\_\_\_\_ in., \_\_\_\_\_ ft.

Sand \_\_\_\_\_

Gas \_\_\_\_\_

Oil \_\_\_\_\_

Total Depth 3310

**PRODUCTION**

1st 24 hrs. Nat. \_\_\_\_\_

1st 24 hrs. after shot \_\_\_\_\_

Gas \_\_\_\_\_ Cu. Ft.

Dry Hole \_\_\_\_\_

Abandoned \_\_\_\_\_

Date

JUL 15 1936 19

S. J. LEWIS Scout