


Section.....20.....Township.....21.....Range.....1-W.....


Well Number.....3 - Kindblade.....

Company.....Continental.....

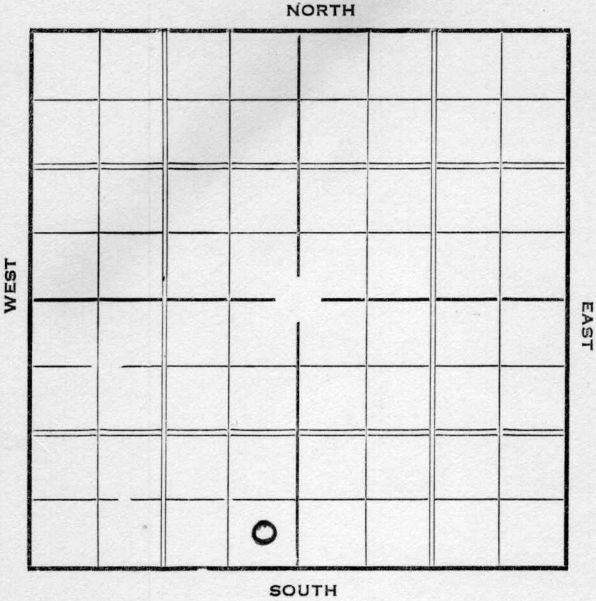

Sec. 20 Twp. 21 R. 1-WWell No. 3-Kindblade Farm
Continental Company Ft. from N. Line330 Ft. from S. Line330 Ft. from E. Line Ft. from W. Line

Elev. 1479

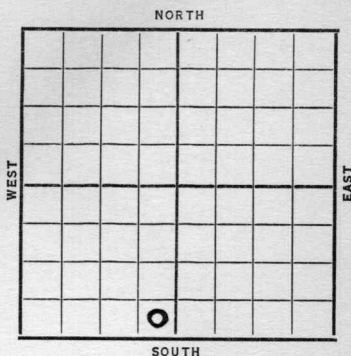

Date	REPORT
1937	
4/28	Location
5/7	Rig
5/14	"
5/21	"
5/28	"
6/4	10" @ 143'. Drlg. 1550'.
6/11	Drlg. 2865'.
6/19	Chat 2906'. Hunton 3280'.
	7" @ 3282'. T.D. 3284'.
	RUST.
6/25	" "
	" "
6/30	7" @ 3282'.
	Hunton 3280'.
	T.D. 3326'.
	4000 A.
	Pot. 682 bbls.
	COMPLETED

McPherson

KANSAS

Map No. _____ Sec. 20 Twp. 21 R. 1 W. 1Well No. 3 - KindbladeContinental

Company

Contractor

FIRST REPORT

SECTION PLAT

2

_____ Ft. from N. Line

330 Ft. from S. Line330 Ft. from E. Line

_____ Ft. from W. Line

Location ✓

Rig up _____

Drilling and Remarks:

RECORD

Cased _____ in., _____ ft.

Sand _____

Gas _____

Oil _____

Total Depth _____

PRODUCTION

1st 24 hrs. Nat. _____

1st 24 hrs. after shot _____

Gas _____ Cu. Ft.

Dry Hole _____

Abandoned _____

Date

APR 28 1937

19

H. D. Hatfield

Scout

KANSAS

McPherson

Map No. 43 Sec. 20 Twp. 21 R. 1 WWell No. 3-KindbladeContinental Company

Contractor

COMPLETED

_____ Ft. from N. Line

330 Ft. from S. Line330 Ft. from E. Line

_____ Ft. from W. Line

SECTION PLAT

Location _____

Rig up _____

Drilling and Remarks:

4000 ARot-682

RECORD

Cased 7 in. 3282 ft.Sand Hutton 3280

Gas _____

Oil _____

Total Depth 3326

PRODUCTION

1st 24 hrs. Nat. _____

1st 24 hrs. after shot _____

Gas _____ Cu. Ft.

Dry Hole _____

Abandoned _____

Date

JUN 30 1937

19

H. D. Hatfield

Scout