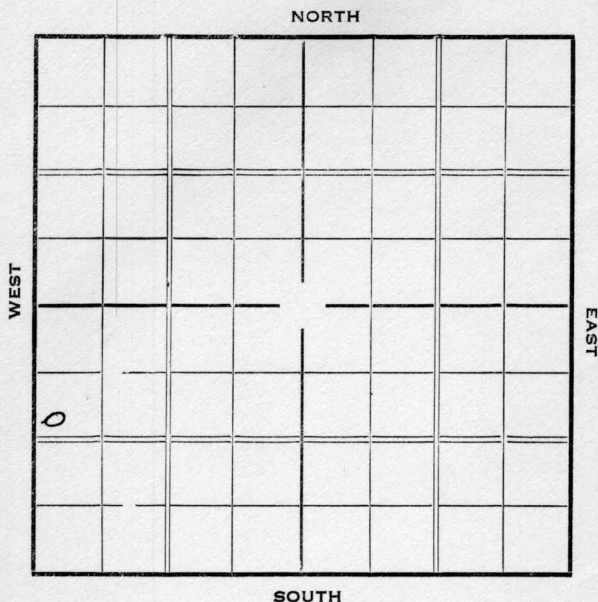



McPHERSON

KANSAS

Section 21 Township 21 Range 1WWell Number 3 BlairCompany Continental

KANSAS

McPherson

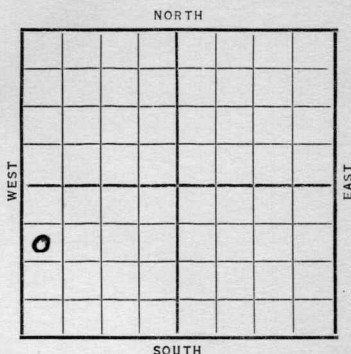Sec. 21 Twp. 21 R. 1-WWell No. #3 Blair FarmContinental Company990 Ft. from N. Line Ft. from S. Line Ft. from E. Line330 Ft. from W. Line*Elv. 1483*Date
1937

REPORT

1/13 Location1/21 R O G1/28 Rig.2/4 13" @ 141'. Drlg. 151'.2/11 Drlg. 22402/18 Chat 2918'. Drlg. 3399'.2/26 Hunton 3320, 7" @ 3322 RUST3/4 " " " " "3/10 Hunton 3320'.

T. D. 3332'.

4000 acid.

Potential 1666.

COMPLETED

M-~~Merion~~ KANSASMap No. 43 Sec. 21 Twp. 21 R. 1W.Well No. 3 BlairContinental

Company

Contractor

SECTION PLAT

590 Ft. from N. Line150 Ft. from S. Line150 Ft. from E. Line280 Ft. from W. Line

FIRST REPORT

0			

Location ✓

Rig up _____

Drilling and Remarks:

RECORD

Cased _____ in., _____ ft.

Sand _____

Gas _____

Oil _____

Total Depth _____

PRODUCTION

1st 24 hrs. Nat. _____

1st 24 hrs. after shot _____

Gas _____ Cu. Ft.

Dry Hole _____

Abandoned _____

Date

JAN 13 1937 19

S. J. LEWIS

Scout

KANSAS

Map No. 43 Sec. 21 Twp. 21 R. 1WWell No. 3 BlairContinental Company

Contractor

SECTION PLAT

0			

990 Ft. from N. Line

_____ Ft. from S. Line

_____ Ft. from E. Line

330 Ft. from W. Line

COMPLETED

Location _____

Rig up _____

Drilling and Remarks:

Hutton 33204000 acidPotential1666

RECORD

Cased _____ in., _____ ft.

Sand _____

Gas _____

Oil _____

Total Depth 3392

PRODUCTION

1st 24 hrs. Nat. _____

1st 24 hrs. after shot _____

Gas _____ Cu. Ft.

Dry Hole _____

Abandoned _____

Date

MAR 10 1937

19

S. J. LEWIS

Scout