


Section 28 Township 21 Range 1-W

Well Number 2 Boechner "A"

Company Continental

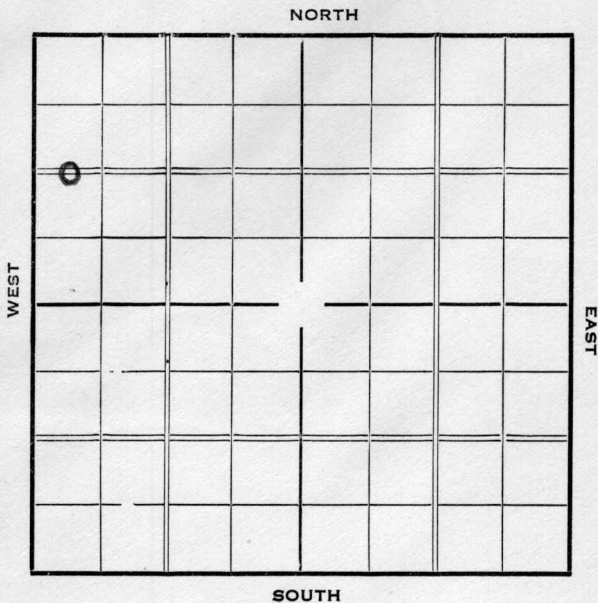

Sec. 28 Twp. 21 R. 1-W

Well No. #2 Boechner "A" Farm
Continental Company


1328 Ft. from N. Line

_____ Ft. from S. Line

_____ Ft. from E. Line

330 Ft. from W. Line

Elev. 1500

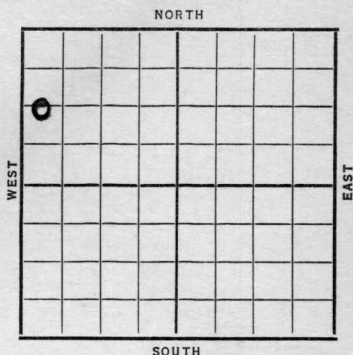

Date	REPORT
1937	
4/14	Location
4/23	10" @ 150'. Drlg. 1365'.
4/30	Drlg. 2926'.
5/7	Hunton 3326'.
	T.D. 3328'. 7" @ 3327'.
	WOC.
5/14	T.D. 3350'. 1200' oil.
	Bailing.
5/19	7" @ 3327'.
	Hunton 3326'.
	T.D. 3350'.
	4000 acid.
	Potential 548 bbls.
	COMPLETED

KANSAS *McPherson*

Map No. _____ Sec. 28 Twp. 21 R. 1W

Well No. 2. Boeckner "A"

Continental Company

Contractor

SECTION PLAT

0			

1328 Ft. from N. Line

_____ Ft. from S. Line

_____ Ft. from E. Line

330 Ft. from W. Line

FIRST REPORT

Location ✓

Rig up _____

Drilling and Remarks:

RECORD

Cased _____ in., _____ ft.

Sand _____

Gas _____

Oil _____

Total Depth _____

PRODUCTION

1st 24 hrs. Nat. _____

1st 24 hrs. after shot _____

Gas _____ Cu. Ft.

Dry Hole _____

Abandoned _____

Date

APR 14 1937 19

S. J. LEWIS Scout

KANSAS *McPherson*

Map No. 43 Sec. 28 Twp. 21 R. 1 W

Well No. 2 Boechner "A"

Continental Company

Contractor

COMPLETED

SECTION PLAT

1328 Ft. from N. Line
____ Ft. from S. Line
____ Ft. from E. Line
330 Ft. from W. Line

0			

Location _____

Rig up _____

Drilling and Remarks:

4000 acid

Pat-548

RECORD

Cased 7 in., 3327 ft.

Sand Hunter 3326

Gas _____

Oil _____

Total Depth 3350

PRODUCTION

1st 24 hrs. Nat. _____

1st 24 hrs. after shot _____

Gas _____ Cu. Ft.

Dry Hole _____

Abandoned _____

Date

MAY 19 1937 19

H. D. Hatfield Scout