


McPherson KANSAS

Section 21 Township 21 Range 1-W

Well Number 4 Blair

Company Continental

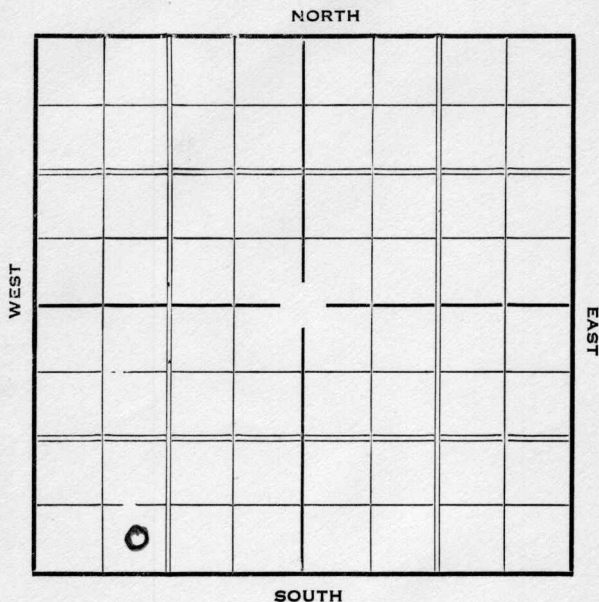

KANSAS

McPherson

Map No. _____ Sec. 21 Twp. 21 R. 1W.Well No. 4 BlairContinental Company_____
Contractor

SECTION PLAT

____ Ft. from N. Line

330 Ft. from S. Line

____ Ft. from E. Line

990 Ft. from W. Line

FIRST REPORT

Location ✓

Rig up _____

Drilling and Remarks:

RECORD

Cased _____ in., _____ ft.

Sand _____

Gas _____

Oil _____

Total Depth _____

PRODUCTION

1st 24 hrs. Nat. _____

1st 24 hrs. after shot _____

Gas _____ Cu. Ft.

Dry Hole _____

Abandoned _____

Date

APR 14 1937 19

S. J. LEWIS Scout

KANSAS

McPherson

Map No. 43 Sec. 21 Twp. 21 R. 1 WWell No. 4-BlairContinental Company

Contractor

COMPLETED

SECTION PLAT

0			

_____ Ft. from N. Line

330 Ft. from S. Line

_____ Ft. from E. Line

990 Ft. from W. Line

Location _____

Rig up _____

Drilling and Remarks:

4000 AcidGot 178 oil(200 wgt.)

RECORD

Cased 7 in., 3320 ft.Sand Hunter 3320

Gas _____

Oil _____

Total Depth 3343

PRODUCTION

1st 24 hrs. Nat. _____

1st 24 hrs. after shot _____

Gas _____ Cu. Ft.

Dry Hole _____

Abandoned _____

Date

JUN 9

1937

19

H. D. Hatfield

Scout