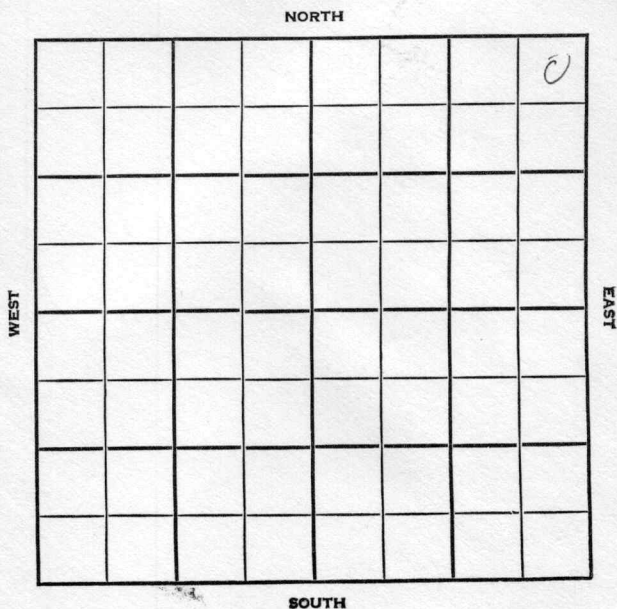


Section 25 Township 21 Range 1WWell No. #1 HiebertCompany Bedell - Catt ,rlg

McPherson

KANSAS

SEC.

25

TWP.

21

R.

1W

WELL NO.

#1 Hiebert

FARM

COMPANY

Bedell-Catt Drlg.

CONTRACTOR

Co. Tools

WILDCAT


_____ FT. FROM N. LINE

_____ FT. FROM S. LINE

_____ FT. FROM E. LINE

_____ FT. FROM W. LINE

NE NE NE

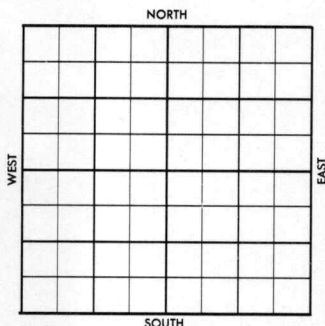

ELEVATION

1956
~~XXXX~~

1505'

REPORT

5-29

Comm. 5-25-56
8" @ 200 w/135
Drlg. 1045

6-13

RTD 3549'
D & A
Dg. 2107', B.L. 2252', L. 2325',
K.C. 2521', B.K.C. 2704', Bgs. 2946',
M. 2948', M. 2959', K. 3253',
Mz. 3362', H. dol. 3363', Mg. 3390',
W 3465', dol. 3486', sd. 3505',
sw. 3540'

ABANDONED

County McPherson Elev. _____
 Sec. 25 Twp. 21 Rge. 1W
 Company Bedell - Catt Drlg.
 Farm Name Hiebert No. 1

TOPS	DEPTH	LOG	DATUM	Loc. in Sec.
Anh.				NE NE NE
TP.				
H.				
Tr.				
Dg.				
Bl.				
L.				Geol.
K.C.				Contr.
B.K.C.				Co. tools
Ce.				Pool
C.				Wildcat
M.				
M.				
K.				
Mz.				
Mq.				
V.				
S.				
S.				
A.				
R.				
Pe.				
G.				
T.D.				

Date Comm. 5-25-56
8" @ 200/135 drlg. 1045

FIRST REPORT

MAY 29 '56

7th 2 1956

2.9

County McPherson Elev. 1505
 Sec. 25 Twp. 21 Rge. 1W
 Company Bedell - Catt Drlg.
 Farm Name Hiebert No. 1

TOPS	DEPTH	LOG	DATUM	Loc. in Sec.
Anh.				NE NE NE
Tr.				
Dg.	2107			
Bl.	2252			
L.	2325			
K.C.	2521			Geol.
B.K.C.	2704			Contr.
Ce. <u>Bgs</u>	2946			Co. tools
C.				
M.	2948			
M.	2959			Pool
K.	3253			Wildcat
Mz.	3362			
Ma. <u>H del</u>	3363			
V. <u>mg</u>	3391			
S. <u>wt</u>	3465			
S. <u>nat</u>	3486			
A. <u>sd</u>	3505			
R. <u>sd</u>	3540			
Pe.				
G.				
T.D.	3549			

ABANDONED

JUN 13 '56

Date Comm. 5-25-56

8" @ 200/135 drlg. 1045 JUN 6 '56

3400 JUN 13 '56 V

RTD 3549

D&A